11	State Well Report		
County: Searce	Part 1 – Driller's Log	For Office Use Only:	-
Permit #: 0- 780	Mississippi Department of Environmental Quality	Aquifer:	
Driller: W. Joel Press.	Office of Land and Water Resources P.O. Box 10631	Well#: <u>L-183</u>	!
Date drilling completed:	Jackson, MS 39289-0631 (601)961-5210	L. S. Elevation:	1
3-25-08	(601)354-6938 (fax)	E-log #:	1

**,**i

State Law requires that this report be prepared by the license holder responsible for the work and filed with the Department at the above address within 30 days of completion of drilling of the well or borehole.

the secre wantess within 50 aavs of com	piedon of ariting of the well or porenoie.				
Information on Well Owner	30 Hell or Borehole Location 38 35 39				
(Landowner if borehole is not for a water well)					
Owner Name C. G. Steppele	Latitude: 88 . 35 . 56				
Mailing Address: 2200 Huy 63 South	Method of LavLong (circle one): Conventional Survey,				
5	NUSSS quad. Hand-held GPS, Survey-grade GPS				
Ludole no 39457	5 4 5 5 5 Sec 33 Twn 35 Rng 66				
City State Zip Code	Distance Direction Verest Jown 2 Miles South of Dutoy, wo				
Telephone No. (60) 508 - 7222	_2_Miles South of Darloy, mo				
Well / Bore	ehole Data				
Date drilling started: Date drilling completed: Date depth: 220 Hole diameter: 4					
3-25-08 3-26-	98				
3-25-08 Location of the source of any surface water used for drilling:					
Method of dosing and volume of Chlorine used in drilling and development: 4 al allow 2000 bally					
Logs run (circle all applicable): No log run) Electric Gamma Ray Density Sonic Neutron Other:					
Purpose of borehole (check one): Water Well Geotechnical/Geological Investigation Ground Source Heat Pump					
Seismic SurveyOther (describe)					
If drilling is not related to water well construction, skip the remainder of this block					
Purpose of Well (check one): Home Industrial Public Supply Irrigation Fish Culture Other:					
If a flowing well, method of flow regulation: Valve Other (describe)					
Static Water Level: 4feet above of below (circle one) land surface Date measured: 2-15-08					
Method of Measurement (circle one) steel tape electric tape air line other:					
22					

Well depth: <u>226</u> Well grouted to a depth of <u>10</u> feet Type of grout (circle one): Neat Cement Bentonite ЪMix Schi Vlastr 10 Casing length: <u>180</u> feet 4 Type of casing: Casing diameter: inches 11 Sel Screen length: 40 feet 4 Type of screen: Screen diameter: \_inches 220 6 feet Screen slot size: inches feet to Setting depth: From\_ Onen hole Natural Development 40 Seven Type of completion (circle all applicable): Gravel packed Underreamed Telescoped Other (describe): feet. If telescoped or more than one screen, describe on next page Top of lap pipe or reduction in casing:


Form: OLWR-SWR-1A

RECEIVED

APR 17 2008

BY: OLWR

## - 183

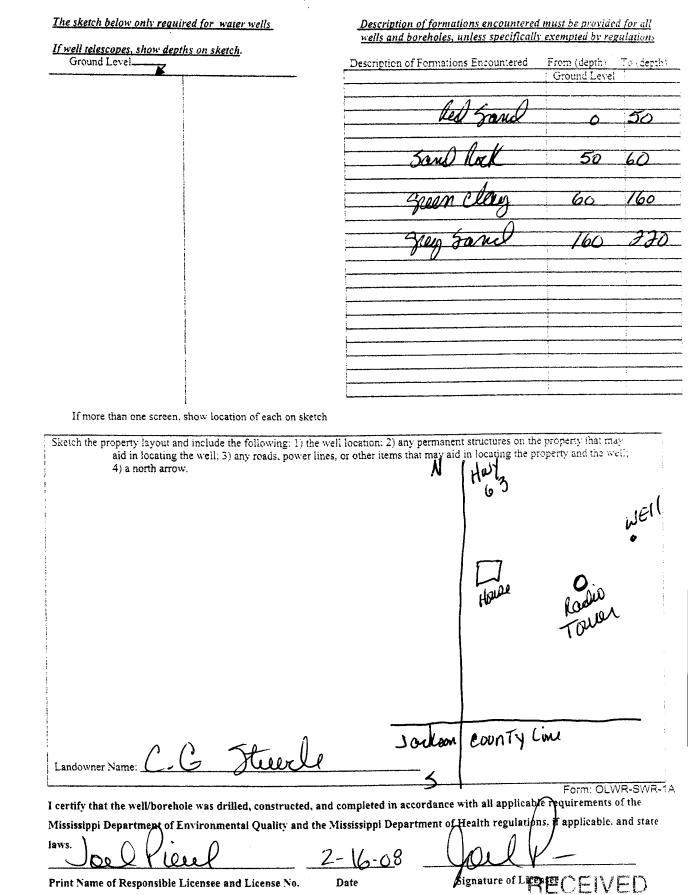

Print Name of Responsible Licensee and License No.

Date

APR 17 2008 BY: OLWR

STATE WELL REPORT					
County: <u>Detted</u> Permit #: <u>0</u> - 780 Driller: <u>U. Jce</u> <u>Pierce</u> Date completed: <u>Detterment</u>	Part 2 Pump Installer's Completion Report Mississippi Department of Environmental Quality Office of Land and Water Resources P.O. Box 10631 Jackson, MS 39289-0631		Quality	For Office Use Only: Aquifer: Well #: <u>L-183</u>	
2 - HO - 08 Corv information from block on Part 1	(601)35	961-5210 4-6938 (fax)		Elevation:	
This part of the report must be completed by a licensed water well contractor or a licensed pump installer. A copy of Part 1 of the report must be attached and both parts filed with the Department at the above address within 30 days of well completion.					
Well Owner Information		Well Location			
Owner Name: C. G Studel Mailing Address: 7200 Hey 63 Touth		Latitude: 88 35 56/ Longitude: 30 44-325			
		Method of Lat/Long (check one): Conventional Survey			
		USGS and	Hand-held (	GPS . Survey-grade GPS	

ž

Jul 1/ JE 1/ Sec 33 735 R/60 uedal w City State Zip Code Nearest Town Direction Distance 2 Miles Joe of Telephone No. (601) 508 - 7222 **Power Type** Pump Type Circle one Circle one Gasoline Engine Natural Gas Diesel Engine Air Lift Jet Submersible Tractor PTO Hand Electric Motor Bucket Turbine Piston Windmill Other (specify): Flowing Well Centrifugal Rotary 5hP Horse Power Rating of Motor: Other (specify): 3-26-88 200 Jrd Section 60 Setting Depth: feet Date Pump Installed: 20 Number of Stages: Rated Pump Capacity: Gallons Per Minute

Pump Test Data	Method of Measuring Water Level Circle one				
Date Well Tested: <u>3-26-08</u> Static Water Level (A): <u>5</u> Feet Below Land Surface	Air Line Electric Measuring Line Steel Tape				
Pumping Water Level (B):Feet Below Land Surface	Other (specify):				
Drawdown [(B) – (A)]: Feet Below Land Surface	For flowing well, measured shut in head:feet				
Test Pumping Rate: Gallons Per Minute	Well yielded GPM with a drawdown of				
Duration of Pump Test (minimum 4 hours): hours	5 feet after <u>48</u> hours of pumping				
A					
I HEREBY CERTIFY that the above statements are true to the best of my knowledge.					
	RECEIVED				

APR 17 2008 BY: OLW R