	State Well Report		
		Part 1	For Office Use Only:
County: Oconge		nt of Environmental Quality	Aquifer:
Permit #:		and Water Resources	1-191
(metwoterup)		Box 10631	Well #: / 06
Drille: Wir Vour	Jackson, I	MS 39289-0631	L. S. Elevation:
Date drilling completed: 0-11-08) 961-5210	
	(601) 354-6938 (fax)		E-log #:
State Law requires that this rep	ort he prepared by th	a drillar in datail and filed w	ith the Department within
30 days of completion of drilling		e ut met in uetan and med w	the Department within
Well Owner Inform		Well	Location
Dwner Name William Was		20.42.000	
		Latitude: 30. 48 . 088	
Mailing Address: 133 MillCl	eek Lane	Method of Lat/Long (circle on	e): Conventional Survey,
			GPS, Survey-grade GPS
Lucedale M	<u>) S 39452</u> ate Zip Code	,	
		Distance Direction Miles	Nearest Town
relephone No. 208)369-1157	<u> </u>		
<u></u>	Well	Data probably took	Sp. gran
\bigcirc			08
Purpose of Well (circle one Home Inc	lustrial Public Supply	Irrigation Fish Culture	Other:
Date well drilling started:	Date	well drilling completed: 10-	11-08
f flowing, method of flow regulation: Va	lve <u>N/</u> Other (describe)	
Static Water Level: <u>50</u> feet al	hove or helow hirdle one)	land surface Date measured	6-11-08
		land surface Date measures	
Method of Measurement (circle one) s	teel tape electric tape	e air line other:	
Hole depth: 188 FT Well de	pth: 188 FT	Well grouted to a depth of	10 feet
Type of grout (circle one): Cement	Bentonite Mix		_
Casing length: <u>173</u> feet Casi	ng diameter: <u>4</u>	inches Type of casing:	pvc
Screen length: <u>15</u> feet Scre	en diameter: <u> </u>	inches Type of screen:	pvc
Screen slot size:	Setting depth: From	_173 _ feet to	88 feet
Type of completion (circle all applicable):	Gravel packed Unde	rreamed Telescoped Open	hole Natural Development
	all.		
Top of lap pipe or reduction in casing: _		lescoped or more than one scree	
logs run (circle all applicable). No log ru	-1.	Density Sonic Neutron (Other:
Name of organization running log(s):	JIA		
certify that the well was drilled, constr			
Department of Environmental Quality a	nd/or the Mississippi De	partment of Health regulations	and state laws.
TackRidadell 0-4-	12		Radie
rint Name of Water Well Contractor and	License No		Water Well Contractor
This Marie of Water Well Contractor and	LICCHSCING.	Z Alonghire of V	

•

•

JUL 0 3 2008 BY: OLWR


L-186

If well telescopes please sketch below and show depths.

Ground Level

	Description of Formations Encountered	From	То
-	Description of Formations Encounter	0	\mathbf{A}
	Change Conduction	\mathbf{X}	10
	Orange Savay Dirt.	- Ro l	-191
	orane livese dand	12	ATH.
	Ornnae Clay Wistreaks Of Sand	ସମ	140
	orange course sand	T40	188
	on ungen starten Cos		
			1
			⊢
			I

If more than one screen, show location of each on sketch

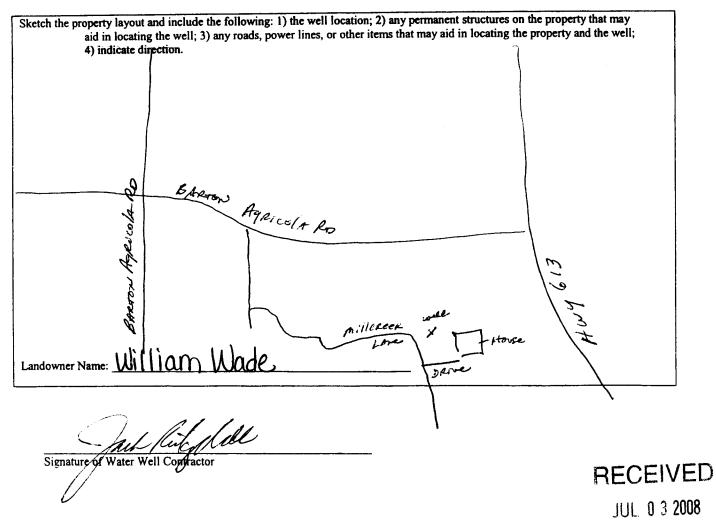

BY: OLWR

STATE W	ELL REPORT			
County: <u>George</u> Pump Installe Mississippi Departm Office of Lan	Part 2 er's Completion Report ment of Environmental Quality and Water Resources	For Office Use Only: Aquifer:		
Driller Cast Water Wellser. Jackson (6). Box 10631 , MS 39289-0631 01) 961-5210) 354-6938 (fax)	Well #:86		
This report should be prepared by the pump installer in d		ent within 30 days of the		
installation of pump. Well Owner Information	Wel	Location		
Owner Name: William Wade	Latitude: 30° 48' 025"	Longitude:		
Mailing Address: 133 Mill Creek Lane	Method of Lat/Long Circle on	-		
	USGS quad, Hand	-held GPS, Survey-grade GPS		
Lucedale Ms 375-42 City State Zip Code	Nury_ Sur 1/4 Sec 12	NWY SW 1/2 Sec 12 TWAT 35 Rng R 60		
	Distance Direction	Nearest Town		
Telephone No. 208)369-1157	$- \underbrace{ - Miles \ \underline{S} \ \omega}_{0} $	f_Aqpicola		
Pump Type Circle one		wer Type ircle one		
Air Lift Jet Submersible	Diesel Engine Gasolin	e Engine Natural Gas		
Bucket Piston Turbine	Electric Motor Hand	Tractor PTO		
Centrifugal Rotary Flowing Well	Windmill Other ((specify):		
Other (specify):	Horse Power Rating of Motor:	IHP		
Date Pump Installed: 6-13-08	Setting Depth: 100 FT.	Droppiper		
Rated Pump Capacity: Callons Per Minute	Number of Stages:/	0		
Pump Test Data		asuring Water Level		
Date Well Tested: 6-12-08		ircle one		
Static Water Level (A):Feet Below Land Surface	Air Line Electric Mean			
Pumping Water Level (B):Feet Below Land Surface	Other (specify):			
Drawdown [(B) - (A)]:Feet Below Land Surface	For flowing well, measured sh	ut in head: <u>MA</u> feet		
Test Pumping Rate: <u>12</u> Gallons Per Minute	Well yielded 45	_GPM with a drawdown of		
Duration of Pump Test (minimum 4 hours): 6,5 hours	feet after	hours of pumping		
I HEREBY CERTIFY that the above statements are true to the bes <u>Jack Ridgdell</u> 0472 Print Name of Pump Installer and License No. (if applicable)	t of my knowledge.	tue staller		
·		RECEIVED		
	V	JUL 0 3 2008		
		BY: OLWR		

,

.

• •