	, State V	Vell Report		
County: Device		–	For Office Use Only:	
County:	Part 1 – Driller's Log Mississippi Department of Environmental Quality		Aquifer:	
Permit #: 0-780	Office of Land and Water Resources		Well #: L735	
Driller: J-Pieul		Box 2309 n, MS 39225		
Date drilling completed: 2-10-15	(601)	961- 5210	L. S. Elevation:	
Date uning completed.	(601)96	1- 5228 (fax)	E-log #:	
State Law requires that this repor				
Department at the above address			<i>l or borehole.</i> orehole Location	
Information on Well Owner (Landowner if borehole is not for a water well)		1		
Owner Name Tyler Co		Latitude: $20^{\circ}45^{\circ}2$	" Longitude: <u>88° 33, 33</u> "	
<i>л</i> –	,	Method of Lat/Long (circle o	ne): Conventional Survey,	
Mailing Address: 114 Stoucyfur Rd				
	0		I GPS, Survey-grade GPS	
i (A. MA	39,157	DE 1/2 TW 1/4 Sec de	5_Twn <u>35_Rng6W</u>	
City State Zip Code		Distance Direction	Nearest Town 🥢	
-			Distance Direction Nearest Town <u>Miles</u> <u>J</u> of <u>Hercola</u> , <u>M</u>	
Telephone No. 278 - 219 -	4910			
	Well / Bor	ehole Data		
Date drilling started: 2-10 -15 Date dri	illing completed: 2-11	- 15 Hole denth: 140	Hole diameter:	
		1 1 4		
Location of the source of any surface water	er used for drilling:	quera as a		
Method of dosing and volume of Chloring	e used in drilling and deve	topment: 2000 60	In sal alone	
Logs run (circle all applicable). No log ru	n Electric Gamma Ray	Density Sonic Neutron	Other:	
Name of organization running log(s):			······································	
Purpose of borehole (check one): Water W	/ell Geotechnical/Geo	logical Investigation Groun	d Source Heat Pump	
Seiemic	Survey Other (<i>describ</i>	0)		
Seismic If drilling is not related	SurveyOther (<i>describ</i> <u>i to water well construction</u>	e)	lock	
Seismic Seismi	<u>l to water well constructi</u>	<u>on, skip the remainder of this b</u>		
If drilling is not related Purpose of Well (check one): Home	i to water well construction	on, skip the remainder of this b y Irrigation Fish Culture	Other:	
If drilling is not related Purpose of Well (check one): HomeI If a flowing well, method of flow regulation	it to water well construction industrial Public Suppl on: Valve (on, skip the remainder of this b y Irrigation Fish Culture Other (describe)	Other:	
If drilling is not related Purpose of Well (check one): HomeI If a flowing well, method of flow regulation	i to water well construction	on, skip the remainder of this b y Irrigation Fish Culture Other (describe)	Other:	
If drilling is not related Purpose of Well (check one): Home II If a flowing well, method of flow regulation	industrial Public Suppl Public Suppl phon: Valve (bove of below (eircle one)	on, skip the remainder of this by y Irrigation Fish Culture Other (describe) land surface Date measured:	Other:	
If drilling is not related Purpose of Well (check one): HomeH If a flowing well, method of flow regulation Static Water Level:feet ab	it to water well construction industrial Public Supplement on: Valve O bove of below (eircle one) teel tape electric tape	on, skip the remainder of this b. y	Other:] - 10 - 15	
If drilling is not related Purpose of Well (check one): Home It If a flowing well, method of flow regulation Static Water Level: It Static Water Level: It It Method of Measurement (circle one) static Well depth: 150 Well grouted to a dependent	it to water well construction industrial Public Supplement industrial Public Supplic Supplicon indust	on, skip the remainder of this base y	Other:] - 10 - 15	
If drilling is not related Purpose of Well (check one): Home It If a flowing well, method of flow regulation Static Water Level: It Static Water Level: It It Method of Measurement (circle one) static Well depth: 150 Well grouted to a definition Casing length: 140 feet Casing	it o water well construction industrial Public Supplement <	on, skip the remainder of this b y	Other: J-10-15 nent Bentonite Mix Plaestic On +	
If drilling is not related Purpose of Well (check one): Home It If a flowing well, method of flow regulation Static Static Water Level: 3 feet all Method of Measurement (circle one) st Well depth: 150 Well grouted to a dee Casing length: 10 feet Screen	it o water well construction industrial Public Supplement industrial Public Supplic Supplicon indust	on, skip the remainder of this bill y	Other: J-10-15 nent Bentonite Mix Plastic Plastic	
If drilling is not related Purpose of Well (check one): Home If If a flowing well, method of flow regulation Static Static Water Level: 3 feet alt Method of Measurement (circle one) st Well depth: 150 Well grouted to a dee Casing length: 10 feet Screen Screen slot size: 10 inches	it o water well construction Industrial Public Supplement bove of below (directe one) itele tape itelet tape electric tape epth of 10 feet Typ ing diameter: getting depth: From	on, skip the remainder of this bill y	 J-10-15 nent Bentonite Mix Plastic Plastic 150_feet	
If drilling is not related Purpose of Well (check one): Home It If a flowing well, method of flow regulation Static Static Water Level: 3 feet all Method of Measurement (circle one) st Well depth: 150 Well grouted to a dee Casing length: 10 feet Screen	it o water well construction industrial Public Supple industris Public Supple	on, skip the remainder of this bill y	Other: J-10-15 ment Bentonite Mix Plastic Plastic 150_feet mode Natural Development	
If drilling is not related Purpose of Well (check one): Home If If a flowing well, method of flow regulation Static Static Water Level: 3 feet alt Method of Measurement (circle one) st Well depth: 150 Well grouted to a dee Casing length: 10 feet Screen Screen slot size: 10 inches	it o water well construction industrial Public Supple industris Public Supple	on, skip the remainder of this bill y	Other: J-10-15 ment Bentonite Mix Plastic Plastic 150_feet mode Natural Development	
If drilling is not related Purpose of Well (check one): Home If If a flowing well, method of flow regulation Static Static Water Level: 3 feet alt Method of Measurement (circle one) st Well depth: 150 Well grouted to a dee Casing length: 10 feet Screen Screen slot size: 10 inches	it o water well construction Industrial Public Supple Industris Public Supple	on, skip the remainder of this bill y	Other: J-10-15 ment Bentonite Mix Plastic Plastic 150_feet mode Natural Development	
If drilling is not related Purpose of Well (check one): Home If If a flowing well, method of flow regulation Static Static Water Level: 3 feet at Method of Measurement (circle one) st Well depth: 150 Well grouted to a de Casing length: 10 feet Casing Screen length: 10 feet Screen Type of completion (circle all applicable) st	it o water well construction Industrial Public Supple Industris Public Supple	on, skip the remainder of this bill y	Other: J-10-15 ment Bentonite Mix Plastic Plastic 150_feet mode Natural Development	

FEB 2 3 2015

Driller: Date completed: Copy information from block on Part 1 This part of the report must be completed by report must be attached and both parts filed Well Owner Information		days of well completion. /ell Location
Owner Name: Tylen Can Mailing Address: 1/4 Stone Curcale aus City State Telephone No. 228) 219 - 49	USGS quad, Hand-he 39452 $5E_{4}5W_{4}$ Sec	Longitude: $88-33-33$ one): Conventional Survey_, Id GPS_V, Survey-grade GPS_ 36 _T 35 _R_6 ω of Across Town of Across Town
Bucket Piston T Centrifugal Rotary F Other (specify): Date Pump Installed: $2 - 10 - 1$	urbine Diesel Engine Gaso Electric Motor Hand Nowing Well Windmill Othe Horse Power Rating of Motor	or: <u>112 hr</u>
Pumping Water Level (B): <u>40</u> Feet Be Drawdown [(B) - (A)]: <u>2</u> Feet Be	Air Line Electric M Air Line Electric M Other (specify): How Land Surface For flowing well, measured Air Line Electric M Other (specify): How Land Surface For flowing well, measured Well yielded	Acasuring Water Level Circle one easuring Line Steel Tape shut in head: feet GPM with a drawdown of feet GPM with a drawdown of feet
This is for (circle one): New Well I HEREBY CERTIFY that the above statemen Oel Out Print Name of Pump Installer and License No.	the are true to the best of my knowledge. $\int \partial H$	Existing Pump

٩.


••

BY: OLWR

The sketch below only required for water wells

	Tens and coreners whites specific and exchipted of regulations			
If well telescopes, show depths on sketch.				
Ground Level	Description of Formations Encountered From (depth) To (depth)			
	- Ground Level			
	Fand 0 33			
	Clay 35 80			
	Sand Grou SO 150			
	Jave Gan Co 110			

If more than one screen, show location of each on sketch

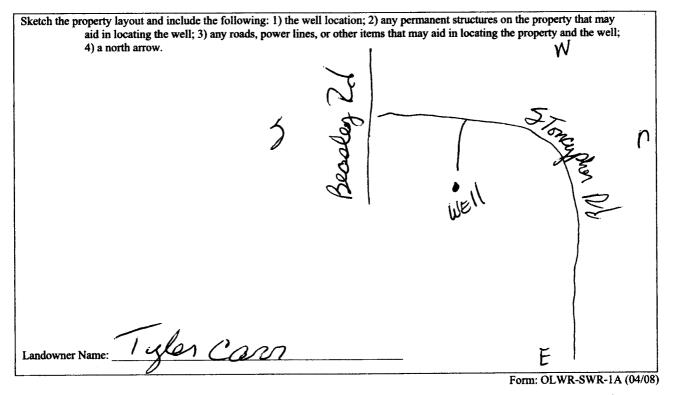

I certify that the well/borehole was drilled, constructed, and completed in accordance with all applicable requirements of the Mississippi Department of Environmental Quality and the Mississippi Department of Health regulations,)f applicable, and state laws.

RECEIVED 7-10-15 OXX FEB 2 3 2015

Print Name of Responsible Licensee and License No.

Date

Signature of Licensee

Description of formations encountered must be provided for all wells and horsholes unless specifically exempted by regulations

See 6