

County: Georg
 Permit #: 0-780
 Driller: J-Plew
 Date drilling completed: 9-22-14

State Well Report
Part 1 - Driller's Log

Mississippi Department of Environmental Quality
 Office of Land and Water Resources
 P.O. Box 2309
 Jackson, MS 39225
 (601)961- 5210
 (601)961- 5228 (fax)

For Office Use Only:
 Aquifer: _____
 Well #: L 234
 L. S. Elevation: _____
 E-log #: _____

State Law requires that this report be prepared by the license holder responsible for the work and filed with the Department at the above address within 30 days of completion of drilling of the well or borehole.

| | | |
|--|--|---|
| Information on Well Owner (Landowner if borehole is not for a water well) Owner Name: <u>Kenneth Matthele</u> Mailing Address: <u>211 Aquada Boulevard</u> <u>Lucedale MS 39452</u> City State Zip Code Telephone No. <u>(601) 508-4300</u> | | Well or Borehole Location Latitude: <u>30° 50' 41"</u> Longitude: <u>88° 36' 31"</u> Method of Lat/Long (circle one): Conventional Survey, <input checked="" type="checkbox"/> USGS quad, <input type="checkbox"/> Hand-held GPS, <input type="checkbox"/> Survey-grade GPS ^{SW} <u>1/4 SE 1/4 Sec 21 Twn 35 Rng 6W</u> Distance Direction Nearest Town <u>1</u> Miles <u>west</u> of <u>Aquada, MS</u> |
|--|--|---|

Well / Borehole Data

Date drilling started: 9-22 Date drilling completed: 9-22 Hole depth: 180 Hole diameter: 2

Location of the source of any surface water used for drilling: Aquada MS
 Method of dosing and volume of Chlorine used in drilling and development: 2000 water seal bleach

Logs run (circle all applicable): No log run Electric Gamma Ray Density Sonic Neutron Other: _____
 Name of organization running log(s): _____

Purpose of borehole (check one): Water Well Geotechnical/Geological Investigation _____ Ground Source Heat Pump _____
 Seismic Survey _____ Other (describe) _____

If drilling is not related to water well construction, skip the remainder of this block

Purpose of Well (check one): Home Industrial _____ Public Supply _____ Irrigation _____ Fish Culture _____ Other: _____

If a flowing well, method of flow regulation: Valve _____ Other (describe) _____

Static Water Level: 3 feet above or below (circle one) land surface Date measured: 9-22

Method of Measurement (circle one) steel tape electric tape air line other: _____

Well depth: 180 Well grouted to a depth of 10 feet Type of grout (circle one): Neat Cement Bentonite _____ Mix _____

Casing length: 170 feet Casing diameter: 2 inches Type of casing: Plastic

Screen length: 10 feet Screen diameter: 2 inches Type of screen: Plastic

Screen slot size: 10 inches Setting depth: From 0 feet to 180 feet

Type of completion (circle all applicable): Gravel packed Underreamed Telescoped Open hole Natural Development
 Other (describe): _____


Top of lap pipe or reduction in casing: _____ feet. *If telescoped or more than one screen, describe on next page*

The sketch below only required for water wells

Description of formations encountered must be provided for all wells and boreholes, unless specifically exempted by regulations

If well telescopes, show depths on sketch.


Ground Level

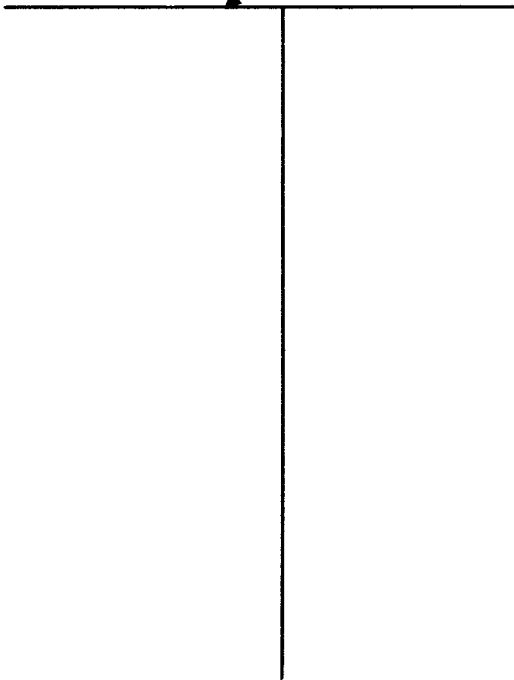

| Description of Formations Encountered | From (depth) | To (depth) |
|---------------------------------------|--------------|------------|
| | Ground Level | |
| Sand | 0 | 25 |
| Clay | 25 | 30 |
| Mud | 30 | 90 |
| Grey Sand | 90 | 180 |
| | | |
| | | |
If more than one screen, show location of each on sketch

Sketch the property layout and include the following: 1) the well location; 2) any permanent structures on the property that may aid in locating the well; 3) any roads, power lines, or other items that may aid in locating the property and the well; 4) a north arrow.

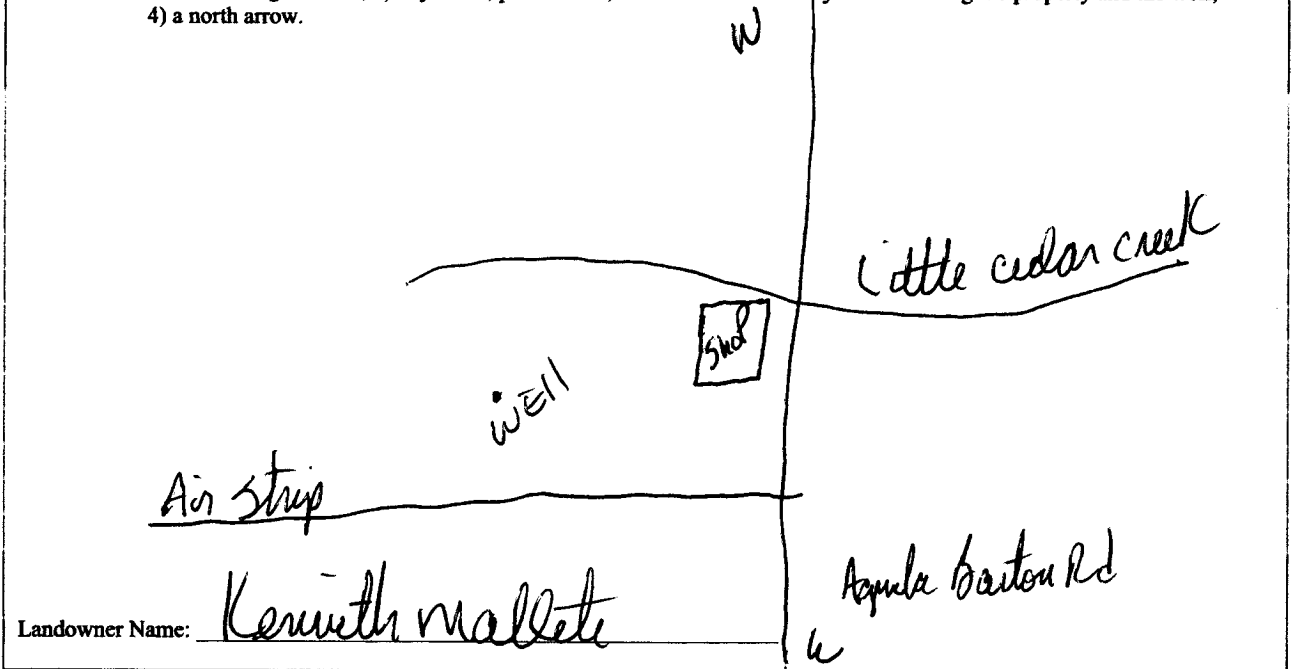

Form: OLWR-SWR-1A (04/08)

I certify that the well/borehole was drilled, constructed, and completed in accordance with all applicable requirements of the Mississippi Department of Environmental Quality and the Mississippi Department of Health regulations, if applicable, and state laws.

Joel Pione 0-780 9-27-14

Print Name of Responsible Licensee and License No.

Date

Signature of Licensee

OCT 01 2014

STATE WELL REPORT

Part 2

Pump Installer's Completion Report
Mississippi Department of Environmental Quality
Office of Land and Water Resources
P.O. Box 2309
Jackson, MS 39225
(601)961-5210
(601)961-5228 (fax)

For Office Use Only:

Aquifer: _____
Well #: L-234
Elevation: _____

County: George
Permit #: 0-780
Driller: Joel P.
Date completed: 9-22-14
Copy information from block on Part 1

This part of the report must be completed by a licensed water well contractor or a licensed pump installer. A copy of Part 1 of the report must be attached and both parts filed with the Department at the above address within 30 days of well completion.

| Well Owner Information | Well Location |
|--|---|
| Owner Name: <u>Kenneth Mallette</u> | Latitude: <u>30 50 41</u> Longitude: <u>88 36 21</u> |
| Mailing Address: <u>211 Aquila Barton Rd</u> | Method of Lat/Long (check one): Conventional Survey _____ USGS quad _____, Hand-held GPS _____, Survey-grade GPS _____ |
| <u>Umsadeh ms</u> <u>39452</u> | <u>SW</u> 1/4 <u>SE</u> 1/4 Sec <u>12</u> T <u>35</u> R <u>6W</u> |
| City State Zip Code | Distance Direction of Nearest Town |
| Telephone No. <u>(601) 508-430</u> | <u>1</u> Miles <u>west</u> of <u>Aquila, ms</u> |

| Pump Type | Power Type |
|---|--|
| Circle one | Circle one |
| Air Lift <input type="radio"/> Jet <input checked="" type="radio"/> Submersible | Diesel Engine <input type="radio"/> Gasoline Engine <input type="radio"/> Natural Gas |
| Bucket <input type="radio"/> Piston <input type="radio"/> Turbine | <input checked="" type="radio"/> Electric Motor <input type="radio"/> Hand <input type="radio"/> Tractor PTO |
| Centrifugal <input type="radio"/> Rotary <input type="radio"/> Flowing Well | Windmill <input type="radio"/> Other (specify): _____ |
| Other (specify): _____ | Horse Power Rating of Motor: _____ |
| Date Pump Installed: <u>9-22-14</u> | Setting Depth: <u>40 drop pipe</u> feet |
| Rated Pump Capacity: <u>10</u> Gallons Per Minute | Number of Stages: <u>2</u> |

| Pump Test Data | Method of Measuring Water Level |
|--|--|
| | Circle one |
| Date Well Tested: <u>9-22-14</u> | <input checked="" type="radio"/> Air Line <input type="radio"/> Electric Measuring Line <input type="radio"/> Steel Tape |
| Static Water Level (A): <u>3</u> Feet Below Land Surface | Other (specify): _____ |
| Pumping Water Level (B): <u>40</u> Feet Below Land Surface | For flowing well, measured shut in head: _____ feet |
| Drawdown [(B) - (A)]: <u>2</u> Feet Below Land Surface | Well yielded <u>10</u> GPM with a drawdown of |
| Test Pumping Rate: <u>10</u> Gallons Per Minute | <u>2</u> feet after <u>48</u> hours of pumping |
| Duration of Pump Test (minimum 4 hours): <u>48</u> hours | |


This is for (circle one): New Well Replacement of Existing Pump Repair of Existing Pump

I HEREBY CERTIFY that the above statements are true to the best of my knowledge.

Joel P. 0-780
Print Name of Pump Installer and License No. (if applicable)

Joel P.
Signature of Pump Installer

Agricola, MS

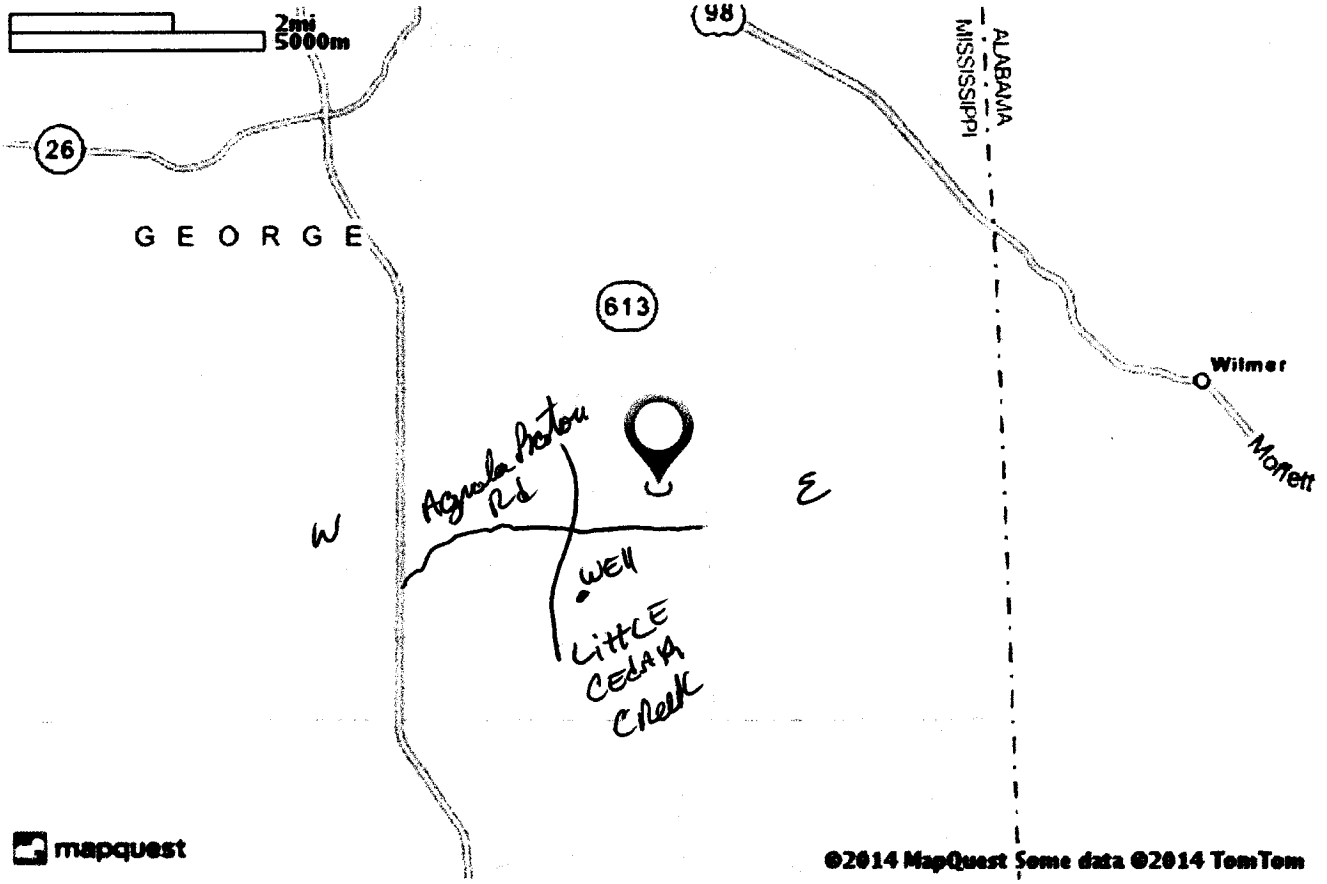

©2014 MapQuest Some data ©2014 TomTom

©2014 MapQuest, Inc. Use of directions and maps is subject to the MapQuest Terms of Use. We make no guarantee of the accuracy of the content, road conditions or route usability. You assume all risk of use. [View Terms of Use](#)

RECEIVED

OCT 01 2014

103