-	all and
County:	3,555)
Permit#: 6	eonge Co.
	t Water Wellsuc
	11-1-15
Date drilling co	mpleted: 7 4 13

STATE WELL REPORT

Part 1

Driller's Log
Mississippi Department of Environmental Quality
Office of Land and Water Resources P.O. Box 2309


Jackson, MS 39225-2309 (601)961-5210 (601)360-0535 (fax)

For Office Use Only:
Well #: <u>L 238</u>
Aquifer:
E-Log #:

State Law requires that this report be prepared by the license holder responsible for the work and filed with the Department at the above address within 30 days of completion of drilling of the well or borehole.

Well Owner Information (Landowner if borehole is not for a water well)	Well or Borehole Location Latitude: 20 449128 Congitude: 088 32 46.44				
Owner Name: Marlene Spencer					
Mailing Address: Betsy Branch ROAD	Method of Lat/Long (check one): Conventional Survey,				
3	USGS quad, Hand-held GPS, Survey-grade GPS				
Lucedale, Ns 39452	NW 14 SESIU , Sec 3636 T 3 5 R & W				
City State Zip Code	12 Miles South of Luceonle				
Telephone No. (25) 591-0474	(Distance) (Direction) (Nearest Town)				
Well / B	orehole Data				
Date drilling started: $4-6-15$ Date drilling completed:	4-6-15Hole depth: 83FT Hole diameter: 2"				
Location of the source of any surface water used for drilling	ng: NA				
Method of dosing and volume of Chlorine used in drilling a	nd development: Igal Pur 1000 Drilling Agalin well				
Logs run (circle all applicable): No log run lectric Gamm					
Name of organization running log(s):					
Purpose of borehole (circle one Water Well) Geotechni	ical/Geological Investigation Ground Source Heat Pump				
Seismic Survey Other	(describe)				
If drilling is not related to water well c	onstruction, skip the remainder of this block				
Purpose of Well (circle all applicable) Home Industrial	Public Supply Irrigation Fish Culture				
Other (describe):					
If a flowing well, method of flow regulation: Valve	, , , , , , , , , , , , , , , , , , ,				
Static Water Level:feet [above or below] and surface Date measured:					
Method of measurement (circle one): Steel tape Electric	tape Air line Other (describe):				
Well depth: 83 FT Well grouted to a depth of: 10 feet Type of grout (circle one): Neat Cement Bentonite Mix					
Casing length:feet Casing diameter:	inches Type of casing:				
Screen length:feet	ainches Type of screen: PVC				
Screen slot size:inches Setting depth	: From <u>73</u> feet to <u>83</u> feet				
Type of completion (circle all applicable): Gravel packed	Underreamed Open hole Natural Development				
Other (describe):	HECEIVED				
Top of lap pipe or reduction in casing:	APR 2 0 2015				
If telescoped or more than	one screen, describe on next page				

Permit #: 6004	e Coi		For Office Use Only: Well #:	
The sketch below only req	uired for water wells	Description of formations encountered and boreholes, unless specifically exem	must be provided pted by regulation	<u>i for all wel</u> ons
<u>If well telescopes, show de</u>	pths on sketch.	Description of Formations Encountered	From (depth)	To (depth)
Ground Level		TOO SOIL	Ground level	<u> </u>
		pranaeclay		10
		pame coorse sand	10	_ 월5
		Gray Clay Orange Coparse Sand) \(\text{\text{2}} \) 	$-\frac{32}{22}$
		change Cesti Se Said	1	
			-	
J			+	
				
į	•			
(6 then are some show	· lanation of analysis almost			
If more than one screen, show	location of each on sketch			
	res on the property that may	in locating the property and the well		
		depart character The		

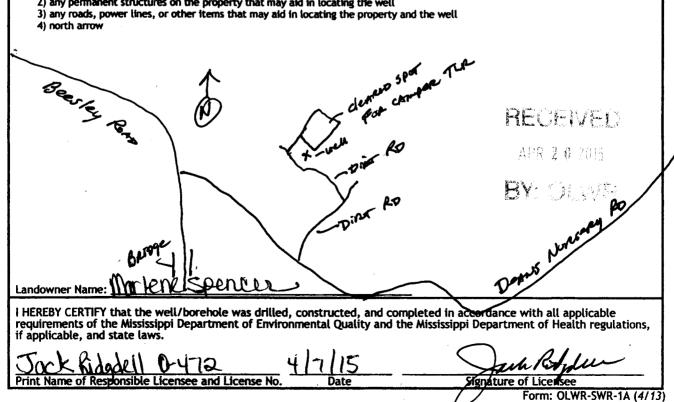

STATE WELL REPORT

County: Permit #: George Co. Driller Coast World Will SVC Date completed: 4-0-15 Copy information from block on Part 1

Part 2

Pump Installer's Completion Report
Mississippi Department of Environmental Quality
Office of Land and Water Resources
P.O. Box 2309

P.O. Box 2309 Jackson, MS 39225-2309 (601)961-5210 (601) 360-0535 (fax)

For Office Use Only:		
Well #: <u>L 238</u>		
Aquifer:		

This part of the report must be completed by a licensed water well contractor or a licensed pump installer. A copy of Part I of the report must be attached and both parts filed with the Department at the above address within 30 days of well completion.			
Well Owner Information	· Well Location		
Owner Name: Mariene Soincox	Latitude 38 44 39. 78 Longitude: 088 32 46.44"		
Mailing Address: Btsy Branch Road	Method of Lat/Long (check one): Conventional Survey,		
,	USGS quad, Hand-held GPS, Survey-grade GPS		
Lucedale, ms 39452 City State Zip Code	NW 4 SESU4, Sec 36 T 35 R GW		
City State Zip Code Telephone No. <u>251</u>) <u>591–0474</u>	12 Miles South of Lucepake (Distance) (Direction) (Nearest Town)		
Pump Tyr	e (circle one)		
, , , , , , , , , , , , , , , , , , ,	Jet Piston Rotary Other (describe):		
	lated Pump Capacity:		
Is This Pump (circle one); (New) Repaired Replacemen			
	pe (circle one)		
Electric Diesel Gasoline Natural Gas Tractor PTO Win	dmill Other (describe):		
Horse Power Rating of Motor: 1 HP Setting Dept	h: HOFT DP feet Number of Stages: 2		
Pump Test Data	for Non Flowing Well		
Date Well Tested: 4-7-15	Duration of Pump Test (minimum 4 hours): hours		
Static Water Level (A): 30 Feet Below Land Surface	Pumping Water Level (B): Feet Below Land Surface		
Drawdown [(B) - (A)]:Feet Below Land Surf	ace Test Pumping Rate: Gallons Per Minute		
Method of measurement (circle one): Steel tape Electric ta			
Pump Test Date	a for Flowing Well		
Measured shut in head:feet.	NA		
Well yieldedGPM with a drawdown of	feet afterhours of pumping		
Meter	nstallation		
Meter Manufacturer:	Meter Serial Number:		
Meter Model Number/Name:	Meter Serial Number:		
Totalizer Register Unit and Multiplier Factor (AF x .001, gal x 1000, etc):			
Installation Date: Meter Installed by:			
Is This Meter (circle one): New Repaired Replaceme	nt		
Important: By submitting the above information you are certifying that this meter was installed to manufacturer standards. For agricultural wells, a list of approved meters is on the MDEQ website.			

I HEREBY CERTIFY that the above statements are true to the	best of my know	ledge	
Jack Ridadell 0-472	4/9/15		Jud Raffee
Print Name of Pump Installer and License No. (if applicable)	Date	II	Signature of Pump Installer 2000
			Form: OLWR-SWR-1B (4/13)

BY DIME