STATE WELL REPORT					
County: George Permit #: Driller: Michael Fryfogle Date drilling completed: 10/31/2021 State Law requires that this report Department at the above address w Well Owner Informat (Landowner if borehole is not for	D Mississippi Depart Office of La Jacks (60 <i>be prepared by the</i> <i>within 30 days of con</i> a water well)	Part 1 priller's Log ment of Environmental Quality and and Water Resources P.O. Box 2309 on, MS 39225-2309 601)961-5555 1)961-5228 (fax) license holder responsible for the mpletion of drilling of the well of	he work and filed with or borehole. hole Location	RECEIVED 02-01-2022 the BY OLWF	
Owner Name: Ricky Franklin Mailing Address: 132B Horse	Ranch rd 39452 Zip Code	Method of Lat/Long (<i>check one</i> USGS quad, Hand-held G <u>SW</u> 1/4 <u>SE</u> 1/4, Sec <u>11</u> Miles <u>SW</u> of (<i>Distance</i>) (<i>Direction</i>)): Conventional Surve PS <u>V</u> , Survey-grade	y, gps _6W	
Well / Borehole Data Date drilling started: 10/31/2021 Date drilling completed: 10/31/2021 Hole diameter: 7					
Location of the source of any surface water used for drilling: None Method of dosing and volume of Chlorine used in drilling and development:					
Purpose of Well (check all applicable): Home Industrial Public Supply Irrigation Fish Culture Other (describe):					
If a flowing well, method of flow regul Static Water Level: <u>38</u> feet Method of measurement (check one): Well depth: <u>120</u> Well grouted to a Casing length: <u>100</u> feet Ca Screen length: <u>20</u> feet S Screen slot size: <u>.10</u> inches Type of completion (check all applicable Other (describe):	E [above or 🗹 belo (check one) Steel tape Electric depth of: <u>10</u> f asing diameter: <u>4</u> Secreen diameter: <u>4</u> Setting depth: e): Gravel packed	ow] land surface Date measure tape Air line Other (<i>describe</i>) eet Type of grout (<i>check one</i>): inches Type of c inches Type of s From <u>100</u> feet to Underreamed Open hole	ed: <u>10/31/202</u> Neat Cement Benton Tasing: <u>Sch40</u> Screen: <u>Wrap</u> <u>120</u> for Natural Development	1 nite Mix eet	
Top of lap pipe or reduction in casing:feet If telescoped or more than one screen, describe on next page					
-, incorpted of more than one server, account on hear page					

	-
County: George	
Permit #:	




For Office Use Only:

Well #: ______L262

The sketch below only required for water wells

If well telescopes, show depths on sketch.

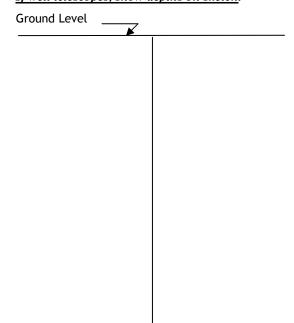

Description of formations encountered must be provided for all wells and boreholes, unless specifically exempted by regulations

Description of Formations Encountered	From (<i>depth</i>)	To (depth)
Sand	Ground level	2
Clay mix	2	32
Sand with clay mix	32	45
Clay	45	50
Sand	50	120

If more than one screen, show location of each on sketch

Sketch the property layout and include the following:

1) the well location

2) any permanent structures on the property that may aid in locating the well

3) any roads, power lines, or other items that may aid in locating the property and the well

4) north arrow



I HEREBY CERTIFY that the well/borehole was drilled, constructed, and completed in accordance with all applicable requirements of the Mississippi Department of Environmental Quality and the Mississippi Department of Health regulations, if applicable, and state laws.

Michael Fryfogle 0408 01/2 Print Name of Responsible Licensee and License No.

01/28/2022 Date



Signature of Licensee