STATE WELL REPORT					
County:    George      Permit #:	D Mississippi Depart Office of La Jacks (60 be prepared by the ithin 30 days of con a water well)	Part 1 priller's Log ment of Environmental Quality and and Water Resources P.O. Box 2309 on, MS 39225-2309 601)961-5555 1)961-5228 (fax) license holder responsible for the mpletion of drilling of the well of	hole Location ngitude: <u>-88.6077</u> ): Conventional Surve	<b>RECEIVED</b> the 02-01-2022 <b>BY OLVVE</b> 7040	
Lucedale  Ms    City  State    Telephone No. ()	39452 Zip Code	NE    1/4    NW    1/4    Sec      7.20    Miles    SE    Original SE    Original SE      (Distance)    (Direction)    Original SE    Original SE	5 <sub>7</sub> 35 <sub>8</sub>	. <u>6W</u>	
Well / Borehole Data      Date drilling started:    11/18/2021    Date drilling completed:    11/18/2021    Hole depth:    118    Hole diameter:    4 1/2      Location of the source of any surface water used for drilling:    None    None      Method of dosing and volume of Chlorine used in drilling and development:					
Purpose of Well (check all applicable): Other (describe): If a flowing well, method of flow regul Static Water Level: <u>50</u> feet Method of measurement (check one): Well depth: <u>118</u> Well grouted to a	Home Industria ation: Valve [ above or Ibelo (check one) Steel tape Electric depth of: <u>10</u> f asing diameter: <u>2</u> creen diameter: <u>2</u> Setting depth: e): Gravel packed	Il Public Supply Irrigation Other ( <i>describe</i> ) ow] land surface Date measur tape Air line⊡Other ( <i>describe</i> ) feet Type of grout ( <i>check one</i> ): inches Type of c inches Type of c 	Fish Culture ed: <u>11/18/202</u> ): Neat Cement Bento casing: <u>Sch40</u> screen: <u>Wrap</u> 0 <u>118</u> fr Natural Developme	1 nite⊡Mix  eet	
If telescoped or more than one screen, describe on next page					

County: George
Permit #:

If well telescopes, show depths on sketch.

×

Ground Level



For Office Use Only:

The sketch below only required for water wells

Description of formations encountered must be provided for all wells and boreholes, unless specifically exempted by regulations


Well #: <u>L264</u>

Description of Formations Encountered	From (depth)	To (depth)
Clay	Ground level	18
Sand	18	40
Clay	40	60
Mix	60	75
Sand	75	80
Mix clay	80	95
Good sand	95	118

If more than one screen, show location of each on sketch

Sketch the property layout and include the following:

- 1) the well location
- 2) any permanent structures on the property that may aid in locating the well
- 3) any roads, power lines, or other items that may aid in locating the property and the well
- 4) north arrow

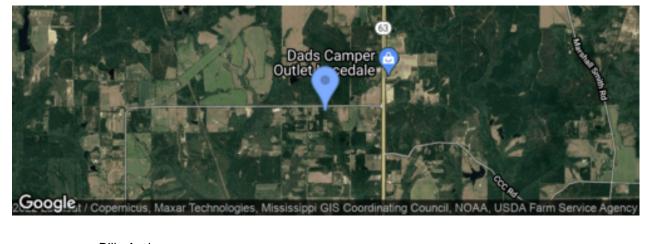

Landowner Name: Billy Anderson

I HEREBY CERTIFY that the well/borehole was drilled, constructed, and completed in accordance with all applicable requirements of the Mississippi Department of Environmental Quality and the Mississippi Department of Health regulations, if applicable, and state laws.

Michael Fryfogle 0408 01/2 Print Name of Responsible Licensee and License No.

01/28/2022 Date



Michael Fryfogle Signature of Licensee