

147

# STATE WELL REPORT Part 1

## Driller's Log

Mississippi Department of Environmental Quality  
Office of Land and Water Resources  
P.O. Box 2309  
Jackson, MS 39225-2309  
(601)961-5555  
(601)961-5228 (fax)

### For Office Use Only:

Well #: L 276  
Aquifer: \_\_\_\_\_  
E-Log #: \_\_\_\_\_

County: George  
Permit #: \_\_\_\_\_  
Driller: Mike + Wade  
Date drilling completed: 5/28/20

State Law requires that this report be prepared by the license holder responsible for the work and filed with the Department at the above address within 30 days of completion of drilling of the well or borehole.

<b>Well Owner Information</b> (Landowner if borehole is not for a water well) Owner Name: <u>Kimberly Stringfellow</u> Mailing Address: <u>2155 Ellis Hodges Rd</u> <u>Woodale</u> MS <u>39452</u> City State Zip Code Telephone No. ( ) _____		<b>Well or Borehole Location</b> Latitude: <u>88.6091</u> Longitude: <u>30.7785</u> Method of Lat/Long (check one): Conventional Survey _____ USGS quad _____, Hand-held GPS _____, Survey-grade GPS _____ <u>NE</u> ¼ <u>NW</u> ¼, Sec <u>20</u> T <u>3S</u> R <u>6W</u> <u>10</u> Miles <u>S</u> of <u>Woodale</u> (Distance) (Direction) (Nearest Town)
--	--	--

**Well / Borehole Data**

Date drilling started: 5/28/20 Date drilling completed: 5/28/20 Hole depth: 90 Hole diameter: 4 1/4

Location of the source of any surface water used for drilling: None

Method of dosing and volume of Chlorine used in drilling and development: \_\_\_\_\_

Logs run (check all applicable):  log run  Electric  Gamma Ray  Density  Sonic  Neutron Other: \_\_\_\_\_

Name of organization running log(s): None

Purpose of borehole (check one): Water Well  Geotechnical/Geological Investigation  Ground Source Heat Pump  Seismic Survey Other (describe) \_\_\_\_\_

RECEIVED  
JUL 10 2020  
BY OLWR

If drilling is not related to water well construction, skip the remainder of this block

Purpose of Well (check all applicable):  Home  Industrial  Public Supply  Irrigation  Fish Culture

Other (describe): \_\_\_\_\_

If a flowing well, method of flow regulation: Valve \_\_\_\_\_ Other (describe) \_\_\_\_\_

Static Water Level: 20 feet  above or  below land surface Date measured: \_\_\_\_\_  
(check one)

Method of measurement (check one)  Steel tape  Electric tape  Air line  Other (describe): \_\_\_\_\_

Well depth: 90 Well grouted to a depth of: 10 feet Type of grout (check one)  Neat Cement  Bentonite  Mix

Casing length: 80 feet Casing diameter: 2 inches Type of casing: 5CH 40

Screen length: 10 feet Screen diameter: 2 inches Type of screen: WRAP

Screen slot size: .10 inches Setting depth: From 80 feet to 90 feet

Type of completion (check all applicable)  gravel packed  Underreamed  Open hole  Natural Development

Other (describe): \_\_\_\_\_

Top of lap pipe or reduction in casing: \_\_\_\_\_ feet


If telescoped or more than one screen, describe on next page



County: \_\_\_\_\_  
 Permit #: \_\_\_\_\_

**For Office Use Only:**  
 Well #: \_\_\_\_\_

*The sketch below only required for water wells  
 If well telescopes, show depths on sketch.*

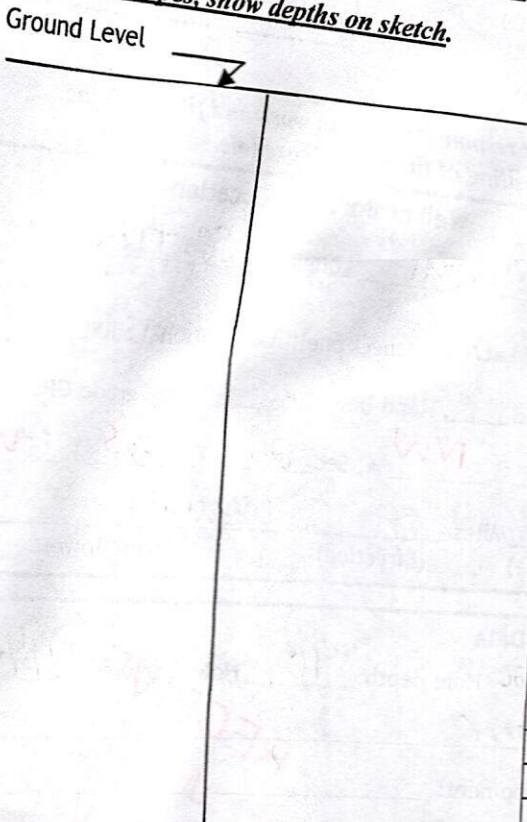

*Description of formations encountered must be provided for all wells  
 and boreholes, unless specifically exempted by regulations*

Description of Formations Encountered	From (depth) Ground level	To (depth)
MIX	0	15
CLAY	15	32
SAND	32	60
CLAY	60	65
SAND	65	90


If more than one screen, show location of each on sketch

Sketch the property layout and include the following:

- 1) the well location
- 2) any permanent structures on the property that may aid in locating the well
- 3) any roads, power lines, or other items that may aid in locating the property and the well
- 4) north arrow

Landowner Name: \_\_\_\_\_

I HEREBY CERTIFY that the well/borehole was drilled, constructed, and completed in accordance with all applicable requirements of the Mississippi Department of Environmental Quality and the Mississippi Department of Health regulations, if applicable, and state laws.

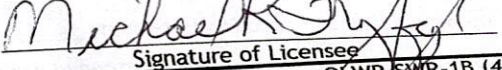  
 Signature of Licensee  
 Michael R. Fink 0408 5/28/20  
 Name of Responsible Licensee and License No. Date



# STATE WELL REPORT

## Part 2

### Pump Installer's Completion Report

Mississippi Department of Environmental Quality  
Office of Land and Water Resources  
P.O. Box 2309  
Jackson, MS 39225-2309  
(601)961-5210  
(601) 360-0535 (fax)

#### For Office Use Only:

Well #: L 276  
Aquifer: \_\_\_\_\_

County: George  
Permit #: \_\_\_\_\_  
Driller: Mike Wade  
Date completed: 5/29/30  
**Copy information from block on Part 1**

*This part of the report must be completed by a licensed water well contractor or a licensed pump installer. A copy of Part 1 of the report must be attached and both parts filed with the Department at the above address within 30 days of well completion.*

Well Owner Information	Well Location
Owner Name: <u>Kimberly Stringfellow</u>	Latitude: <u>38.6091</u> Longitude: <u>30.7785</u>
Mailing Address: <u>2155 Ellis Hodges Rd</u>	Method of Lat/Long (check one): Conventional Survey _____, USGS quad _____, Hand-held GPS _____, Survey-grade GPS _____
<u>Weeddale</u> City <u>MS</u> State <u>39452</u> Zip Code	<u>NE</u> ¼ <u>NW</u> ¼, Sec. <u>20</u> T. <u>3S</u> R. <u>6W</u>
Telephone No. ( ) _____	<u>10</u> Miles <u>S</u> of <u>Weeddale</u> (Distance) (Direction) (Nearest Town)

**Pump Type (check one)**  
 Submersible  Turbine  Air Lift  Centrifugal  Flowing Well  Jet  Piston  Rotary  Other (describe): \_\_\_\_\_  
 Date Pump Installed: 5/29/30 Rated Pump Capacity: 10 Gallons Per Minute  
 Is This Pump (check one):  New  Repaired  Replacement

**Power Type (check one)**  
 Electric  Diesel  Gasoline  Natural Gas  Tractor PTO  Windmill  Other (describe): \_\_\_\_\_  
 Horse Power Rating of Motor: 1 Setting Depth: 50 feet Number of Stages: 2

**Pump Test Data for Non Flowing Well**  
 Date Well Tested: 5/29/30 Duration of Pump Test (minimum 4 hours): 4 hours  
 Static Water Level (A): 20 Feet Below Land Surface Pumping Water Level (B): 24 Feet Below Land Surface  
 Drawdown [(B) - (A)]: 4 Feet Below Land Surface Test Pumping Rate: 10 Gallons Per Minute  
 Method of measurement (check one): Steel tape  Electric tape  Air line  Other (describe): \_\_\_\_\_

**Pump Test Data for Flowing Well**  
 Measured shut in head: \_\_\_\_\_ feet.  
 Well yielded \_\_\_\_\_ GPM with a drawdown of \_\_\_\_\_ feet after \_\_\_\_\_ hours of pumping

**Meter Installation**  
 Meter Manufacturer: \_\_\_\_\_ Meter Serial Number: \_\_\_\_\_  
 Meter Model Number/Name: \_\_\_\_\_ Type of Meter: \_\_\_\_\_  
 Totalizer Register Unit and Multiplier Factor (AF x .001, gal x 1000, etc): \_\_\_\_\_  
 Installation Date: \_\_\_\_\_ Meter installed by: \_\_\_\_\_  
 Is This Meter (check one):  New  Repaired  Replacement  
*Important: By submitting the above information you are certifying that this meter was installed to manufacturer standards. For agricultural wells, a list of approved meters is on the MDEQ website.*

RECEIVED  
JUL 10 2020  
BY OLWR

I HEREBY CERTIFY that the above statements are true to the best of my knowledge.  
Michael R Fryfogle 0408      \_\_\_\_\_  
 Print Name of Pump Installer and License No. (if applicable)      Date  
 \_\_\_\_\_  
 Signature of Pump Installer



near Lucedale — George



1 of 1