

George
L 2002
6-25-75

MISSISSIPPI
BOARD OF WATER COMMISSIONERS
416 North State Street
Jackson, Mississippi 39201

WATER WELL DRILLERS LOG

George
Jackson


June 25 1975 *Colville Water Aug.* firm name *George* county well located *Jackson*

LANDOWNER:	description of formations encountered	from	to
<i>Phillip</i>			
<i>Deussy</i>	<i>Clay</i>	<i>0</i>	<i>66</i>
<i>Boston Community</i> (mailing address)	<i>subd</i>	<i>66</i>	<i>80</i>

WELL LOCATION:
sec. *33* T *3* N R. *6* E *132*
13 miles *S* *Lucedale*
(distance) (direction) (nearest town)

WELL PURPOSE: *Home*
(home, irrigation, municipal, industrial)

- WELL COMPLETION DATA:
- (1) diameter (inches) 7
 - (2) total depth (feet) 80
 - (3) static water level (feet) 57 *below* above top of ground.
 - (4) casing plastic 75
(material) (depth)
(size) If telescope see back.
 - (5) screen 5' 75
(length) (depth to top)
(size) plastic (material)
 - (6) pump 1 8
(HP) (yield gpm)
elec
(type power)
 - (7) electric log no
(yes or no)
 - (organization running log)
 - (8) how well bottom plugged BP Valve

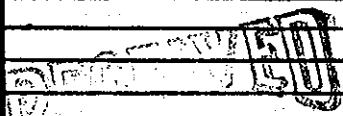

OCT 31 1975

MISS. BD. OF WATER COMM

DRILLERS REMARKS: