

GEORGE
L 2533
6-3-81

MISSISSIPPI
BOARD OF WATER COMMISSIONERS
416 North State Street
Jackson, Mississippi 39201

WATER WELL DRILLERS LOG

6-3 date well completed 1981 Pierce Drilling Co. film name George county well located

LANDOWNER: Sandra Steede

description of formations encountered

from to

Lucedale, Ms
(mailing address)

TOP Soil
Good Sand

0 20
20 45

WELL LOCATION:


sec. 28 T-3 N R-10 E
15 miles South of Lucedale
(distance) (direction) (nearest town)

WELL PURPOSE:

(home, irrigation, municipal, industrial)

WELL COMPLETION DATA:

- (1) diameter (inches) 2"
- (2) total depth (feet) 45'
- (3) static water level (feet) 30' below top of ground.
- (4) casing Plastic, 40' (material) (depth)
D (size) If telescope see back.
- (5) screen 5' length, 45' depth to top
D10, Plastic (size) (material)
- (6) pump 1 (HP) 10 (yield gpm)
Electric (type power)
- (7) electric log (yes or no)
- (organization running log)
- (8) how well bottom plugged BW

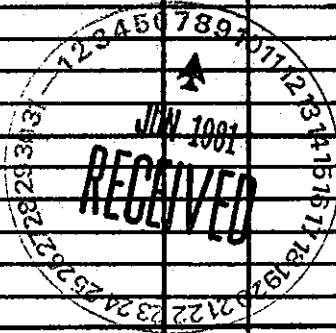

DRILLERS REMARKS: