

GEORGE
L 2034
5-28-81

MISSISSIPPI
BOARD OF WATER COMMISSIONERS
416 North State Street
Jackson, Mississippi 39201

WATER WELL DRILLERS LOG

5-28 1981 Pierce Drilling George
date well completed firm name county well located

LANDOWNER: Tommy Dubose

description of formations encountered

from to

Lucedale, Ms
(mailing address)

| | | |
|-----------|----|----|
| TOP Soil | 0 | 15 |
| Clay | 15 | 25 |
| Sand | 25 | 30 |
| Clay | 30 | 35 |
| Good Sand | 35 | 70 |

WELL LOCATION:


sec. 32 T-3 N R-6 E
12 miles South of Lucedale
(distance) (direction) (nearest town)

WELL PURPOSE:

(~~from~~) Irrigation, municipal, industrial

WELL COMPLETION DATA:

- diameter (inches) 2"
- total depth (feet) 70'
- static water level (feet) 30' ^{below} above top of ground.
- casing Plastic 65'
(material) (depth)
0 If telescope see back.
(size)
- screen 5' 70'
(length) (depth to top)
010 Plastic
(size) (material)
- pump 1 8
(HP) (yield gpm)
Electric
(type power)
- electric log (yes or no)
(organization running log)
- how well bottom plugged BW

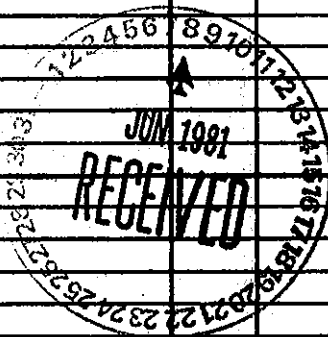

DRILLERS REMARKS: