

MISSISSIPPI DEPARTMENT OF NATURAL RESOURCES

Bureau of Land and Water Resources

Southport Mall

P.O. Box 10631

Jackson, Mississippi 39209

WATER WELL DRILLERS LOG

L 2050  
George  
6-1-85

6-1-85 date well completed 1985 Jim Doyle well owner George county well located


LANDOWNER: Bill Kittrell  
Lucedale, MS (mailing address)

description of formations encountered	from	to
top soil	0	10
clay	10	20
red sand	20	30
small clay	30	50
sand	50	85

WELL LOCATION:  
sec. 12 T-3 N R-6 E  
2 miles W of Oscola  
(distance) (direction) (nearest town)

WELL PURPOSE:  
(home, irrigation, municipal, industrial)

- WELL COMPLETION DATA:
- (1) diameter (inches) 4"
  - (2) total depth (feet) 85
  - (3) static water level (feet) 40 <sup>below</sup> top of ground
  - (4) casing PVC, 25' (material) (depth)  
W If telescope see back. (size)
  - (5) screen 10' 75' (length) (depth to top)  
4" PVC (size) (material)
  - (6) pump 1/3 HP 15 (yield gpm)  
Elect (type power)
  - (7) electric log m (yes or no)
  - (organization running log)
  - (8) how well bottom plugged PVC  
PVC

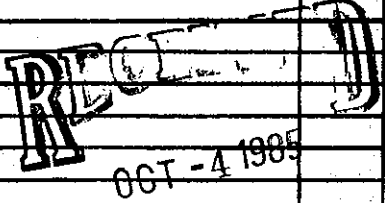

Department of Natural Resources  
Bureau of Land & Water Resources

DRILLERS REMARKS: