


GEORGE
L 2056

MISSISSIPPI
BOARD OF WATER COMMISSIONERS
416 North State Street
Jackson, Mississippi 39201

WATER WELL DRILLERS LOG

7-12-80 Pierce Drilling Co. George
date well completed firm name county well located

LANDOWNER: <u>D.B. Church</u>	description of formations encountered	from	to
<u>Morella</u>	<u>top soil</u>	<u>0</u>	<u>10</u>
<u>Lucedale, Ms</u>	<u>clay</u>	<u>10</u>	<u>20</u>
(mailing address)	<u>good sand</u>	<u>20</u>	<u>35</u>
WELL LOCATION: sec. <u>36</u> T. <u>3</u> N R. <u>6</u> E <u>6</u> miles <u>South</u> of <u>Lucedale</u> (distance) (direction) (nearest town)	<u>clay</u>	<u>35</u>	<u>120</u>
WELL PURPOSE: <u>home</u> , Irrigation, municipal, Industrial	<u>good sand</u>	<u>120</u>	<u>150</u>
WELL COMPLETION DATA:			
(1) diameter (inches) <u>2"</u>			
(2) total depth (feet) <u>150'</u>			
(3) static water level (feet) <u>70'</u> <u>below</u> top of ground.			
(4) casing <u>plastic</u> , <u>145'</u> (material) (depth)			
<u>0</u> if telescope see back. (size)			
(5) screen <u>5'</u> , <u>150'</u> (length) (depth to top)			
<u>006</u> , <u>plastic</u> (size) (material)			
(6) pump <u>1</u> , <u>10</u> (HP) (yield gpm)			
<u>electric</u> (type power)			
(7) electric log <u>yes</u> (yes or no)			
(organization running log)			
(8) how well bottom plugged <u>Beu</u>			
DRILLERS REMARKS:			

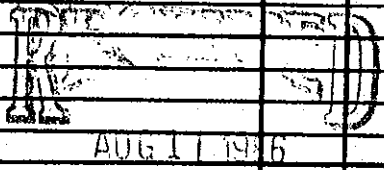

Department of Natural Resources
Bureau of Land & Water Resources