

George
M76
6-17-74


MISSISSIPPI
BOARD OF WATER COMMISSIONERS
416 North State Street
Jackson, Mississippi 39201

CODED

WATER WELL DRILLERS LOG

June 12 1974 Self-Digger George
date well completed film name county well located

LANDOWNER: <u>J.V. Jordan</u>	description of formations encountered	from	to
<u>PT. 1</u> <u>Wilma</u> (mailing address)			
WELL LOCATION: sec <u>35</u> T <u>3</u> N R <u>5</u> E <u>4</u> miles <u>south</u> of <u>Marvell</u> (distance) (direction) (nearest town)	<u>sand clay (red)</u>	<u>0'</u>	<u>10'</u>
WELL PURPOSE: (home, irrigation, municipal, industrial)	<u>white clay</u> CODED	<u>12'</u>	<u>40'</u>
WELL COMPLETION DATA: (1) diameter (inches) <u>2</u>	<u>clay w/ sand streak</u>	<u>40'</u>	<u>80'</u>
(2) total depth (feet) <u>75</u>	<u>med coarse white sand</u>	<u>80'</u>	<u>90'</u>
(3) static water level (feet) <u>51'</u> below above top of ground.			
(4) casing <u>PVC</u> <u>91'</u> (material) (depth)			
(5) screen <u>4</u> <u>91'</u> (length) (depth to top)			
(6) pump <u>1</u> <u>12</u> (HP) (yield gpm)			
(7) electric log <u>no</u> (yes or no)			
(8) how well bottom plugged <u>B.W.D.</u>			
DRILLERS REMARKS:			

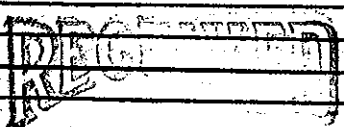

JUN 21 1974

MISS. BD. OF WATER COMM.