


GEORGE
M 103

MISSISSIPPI
BOARD OF WATER COMMISSIONERS
416 North State Street
Jackson, Mississippi 39201

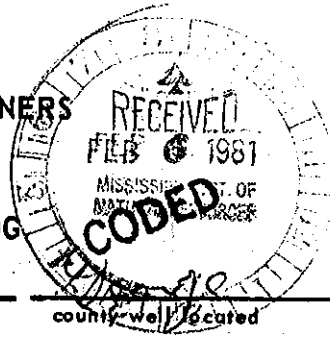

WATER WELL DRILLERS LOG

1-30-81
1/30/81 19 date well completed
Gifford Well Co firm name
county well located

LANDOWNER:	description of formations encountered	from	to
Ronald Cockram Rt 1 Wilmore Pla. (mailing address)			
WELL LOCATION:	muddy sand	22	20'
sec. 30 T 3 N R 4 E S W		26'	
2 miles S of Howells (distance) (direction) (nearest town)	sand		120
WELL PURPOSE: (home, irrigation, municipal, industrial)	muddy sand & clay	130	
WELL COMPLETION DATA:			120'
(1) diameter (inches) 4"			
(2) total depth (feet) 126			
(3) static water level (feet) 22 below top of ground.	sand	120	120'
(4) casing PVC 80' (material) (depth)			
(5) screen 25' 80 (size) (length) (depth to top)			
(6) pump 1/2 (HP) 100 (yield gpm)			
(7) electric log no (yes or no)			
(8) how well bottom plugged B.V.			
DRILLERS REMARKS:			