

CODED

MISSISSIPPI BOARD OF WATER COMMISSIONERS
416 North State Street
Jackson, Mississippi 39201

WATER WELL DRILLERS LOG

George
M 10.4
5-19-81
May 19 1981

Shumock Well Co

George

date well completed

firm name

county well located

LANDOWNER: Mr. Dean
Rt 2 Lucedale, Miss.
Sun Bay Nursery
(mailing address)

description of formations encountered	from	to
Red Clay Sand	0	15'
SAND	15	28'
CLAY	28	37'
sphd	37	53'
Blue Clay	53	85'
SAND	85	120'
med. sand	120	150'

WELL LOCATION:

sec. 31 T. 3 N. R. 5 E.
S W
3 miles West of Harkston
(distance) (direction) (nearest town)

WELL PURPOSE: NURSERY
(home, irrigation, municipal, industrial)

WELL COMPLETION DATA:

- (1) diameter (inches) 4"
- (2) total depth (feet) 150'
- (3) static water level (feet) 60' below above top of ground.
- (4) casing PVC, 130'
(material) (depth)
4" if telescope see back.
(size)
- (5) screen 20', 130'
(length) (depth to top)
4", PVC
(size) (material)
- (6) pump 5, 85
(HP) (yield gpm)
220
(type power)
- (7) electric log NO
(yes or no)
- (organization running log)
- (8) how well bottom plugged WASH
DAVE

CODED




DRILLERS REMARKS:

CODED

If well telescopes please sketch and show depths.

GROUND LEVEL

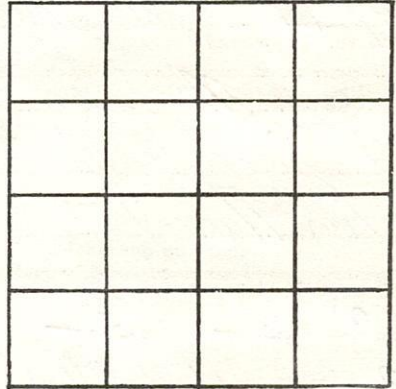

SECTION _____

Please indicate well location X.

ADDITIONAL INFORMATION

If more than one screen, show locations of each on sketch.