
State W	ell Report	For Office Use Only:			
County Group P	Part 1				
	t of Environmental Quality and Water Resources	Aquifer:			
P.O.E	Box 10631	Well #: <u>M-167</u>			
Jackson, M	IS 39289-0631 961-5210	L. S. Elevation:			
(601)35-	4-6938 (fax)	E-log #:			
State Law requires that this report be prepared by the 30 days of completion of drilling of the well.	driller in detail and filed w	vith the Department within			
Well Owner Information					
Owner Name_ <u>Steven Fineburg</u>	Latitude: <u>30° 48° 066</u> " Longitude <u>188° 30° 11</u>				
Mailing Address: 153 Corley Rol	Method of Lat/Long (circle or	ne): Conventional Survey,			
		GPS, Survey-grade GPS			
Lucedale MS 39452 City State Zip Code	NW 14.5E 1/4 Sec_ 8				
Telephone No. (601) 947-8003	Distance Direction Necrost Tour				
Weil I	Data	-			
Purpose of Well (circle one) Home Industrial Public Supply	Irrigation Fish Culture	Other:			
Date well drilling started: $5 - 2 - 07$ Date well drilling completed: $5 - 2 - 07$					
If flowing, method of flow regulation: Valve $N/r^2$ Other (de	escribe)				
Static Water Level: 40 feet above or below circle one) la	and surface Date measured:_	5-2-07			
Method of Measurement (circle one) steel tape electric tape	air line other:				
Hole depth: <u>160</u> Well depth: <u>160</u> Well grouted to a depth of <u>10</u> feet					
Type of grout (circle one): Cement Bentonite Mix					
Casing length: feet Casing diameter: inches Type of casing:					
Screen length: <u>20</u> feet Screen diameter: <u>4</u> inches Type of screen: <u>pvC</u>					
Screen slot size: <u>. COS</u> inches Setting depth: From <u>140</u> feet to <u>160</u> feet					
Type of completion (circle all applicable): Gravel packed Underreamed Telescoped Open hole Natural Development					
Other (describe):					
Top of lap pipe or reduction in casing:feet. If tele	escoped or more than one scre	en, describe on back of page			
Logs run (circle all applicable): No log run Electric Gamma Ray	Density Sonic Neutron (	Other:			
Name of organization running log(s): NIA					
I certify that the well was drilled, constructed, and completed in a Department of Environmental Quality and/or the Mississippi Dep					
Jack Ridadell 0-472		, Relace			
Print Name of Water Well Contractor and License No.	Signature of V	Water Well Contractor			
		RECEIVE			
		MAY 3 1 2007			

BY: OLWR

M-167

If well telescopes please sketch below and show depths.

If more than one screen, show location of each on sketch

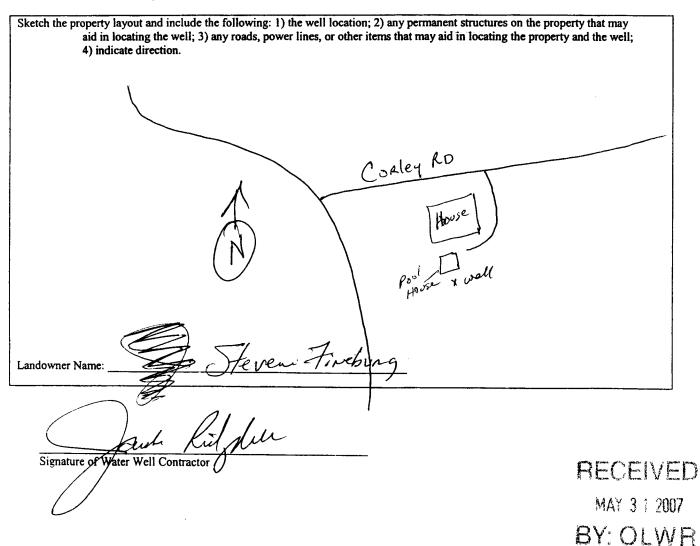

County: <u>George</u> Permit #: Driller ( <u>Cast Wat</u> Date completed: <u>5</u> -c	<u>ler Wells</u> a 2-07	Pump Installe: Mississippi Departm Office of Land P.O Jackson, (60 (601):	Part 2 r's Completion Report ent of Environmental Quality d and Water Resources . Box 10631 MS 39289-0631 1)961-5210 354-6938 (fax) tail and filed with the Departme	For Office Use Only: Aquifer: Well #:	
installation of p				ll Location	
	venFire	burg	Latitude: $\frac{20^{\circ} 48'}{006''}$ Longitude: $\frac{088^{\circ} 30'}{164''}$ Method of Lat/Long (circle one): Conventional Survey,		
LUCEDALE MS 39452 City State Zip Code Telephone No. (601)947-8003		USGS quad, Hand-held GPS) Survey-grade GPS $\frac{NW}{4.5E} \times Sec \ 8 \qquad Twn T35 \ Rng \ R5W$ Distance Direction Nearest Town $\frac{1^{1/2}}{Miles} \ SE \qquad of \ Agricolar$			
Pump Type Circle one			wer Type ircle one		
Air Lift	Jet	Submersible	Diesel Engine Gasolir	ne Engine Natural Gas	
Bucket	Piston	Turbine	Electric Motor Hand	Tractor PTO	
Centrifugal	Rotary	Flowing Well	Windmill Other	(specify):	
Other (specify):			Horse Power Rating of Motor	3HP	
Date Pump Installed: <u>5-4-07</u>		Setting Depth: 120FT. Droppipe feet			
Rated Pump Capacity	<u>    4</u> 0	Gallons Per Minute	Number of Stages:	//	
Pump Test Data Date Well Tested: 5-4-07		Method of Measuring Water Level Circle one			
Static Water Level (A		Feet Below Land Surface (	Air Line Electric Meas	suring Line Steel Tape	
	. 17 .	Feet Below Land Surface	Other (specify):		
		Feet Below Land Surface	For flowing well, measured sh	ut in head: N/A feet	
		Gallons Per Minute	Well yieldedGPM with a drawdown of		
	, .	ours):hours		N/A hours of pumping	
JackRide	odell O.	tatements are true to the best -472 nse No. (if applicable)	of my knowledge Signature of Pomp Ins	talfun staller BECEIVE	
				MAY 3 1 70	