

# State Well Report

## Part 1 - Driller's Log

Mississippi Department of Environmental Quality  
Office of Land and Water Resources  
P.O. Box 2309  
Jackson, MS 39225  
(601)961- 5210  
(601)961- 5228 (fax)

### For Office Use Only:

Aquifer: \_\_\_\_\_  
Well #: M221  
L. S. Elevation: \_\_\_\_\_  
E-log #: \_\_\_\_\_

County: George  
Permit #: 0-780  
Driller: J-Pine  
Date drilling completed: 4-18-13

*State Law requires that this report be prepared by the license holder responsible for the work and filed with the Department at the above address within 30 days of completion of drilling of the well or borehole.*

Information on Well Owner <i>(Landowner if borehole is not for a water well)</i>	Well or Borehole Location
Owner Name: <u>Tiffany Griffith</u>	Latitude: <u>30° 44' 131"</u> Longitude: <u>88° 27' 171"</u>
Mailing Address: <u>131 Bushnell Lane</u>	Method of Lat/Long (circle one): <u>Hand-held GPS</u> Conventional Survey
City: <u>Lucas</u> State: <u>MS</u> Zip Code: <u>39452</u>	USGS quad, <u>Hand-held GPS</u> Survey-grade GPS
Telephone No. <u>(228) 219-1313</u>	<u>NE 1/4 NE 1/4</u> Sec <u>35</u> Twn <u>T35</u> Rng <u>9W</u>
	SW SE Direction: <u>6</u> Miles <u>West</u> of <u>Agula, MS</u>

**Well / Borehole Data**

Date drilling started: 4-18-13 Date drilling completed: 4-18-13 Hole depth: 50 Hole diameter: 2

Location of the source of any surface water used for drilling: Agula, MS

Method of dosing and volume of Chlorine used in drilling and development: 2000 water 4gal chlorid

Logs run (circle all applicable): No log run Electric Gamma Ray Density Sonic Neutron Other: \_\_\_\_\_

Name of organization running log(s): \_\_\_\_\_

Purpose of borehole (check one): Water Well  Geotechnical/Geological Investigation \_\_\_\_\_ Ground Source Heat Pump \_\_\_\_\_

Seismic Survey \_\_\_\_\_ Other (describe) \_\_\_\_\_

*If drilling is not related to water well construction, skip the remainder of this block*

Purpose of Well (check one): Home  Industrial \_\_\_\_\_ Public Supply \_\_\_\_\_ Irrigation \_\_\_\_\_ Fish Culture \_\_\_\_\_ Other: \_\_\_\_\_

If a flowing well, method of flow regulation: Valve \_\_\_\_\_ Other (describe) \_\_\_\_\_

Static Water Level: 3 feet above below (circle one) land surface Date measured: 4-18-13

Method of Measurement (circle one) steel tape electric tape air line other: \_\_\_\_\_

Well depth: 50 Well grouted to a depth of 10 feet Type of grout (circle one): Neat Cement Bentonite Mix

Casing length: 40 feet Casing diameter: 2 inches Type of casing: Sch 40 Plastic

Screen length: 10 feet Screen diameter: 2 inches Type of screen: Sch 40 Plastic

Screen slot size: 10 inches Setting depth: From 040 feet to 50 feet

Type of completion (circle all applicable): Gravel packed Underreamed Telescoped Open hole Natural Development

Other (describe): \_\_\_\_\_

Top of lap pipe or reduction in casing: \_\_\_\_\_ feet. *If telescoped or more than one screen, describe on next page*

Form: OLWR-SWR-1A (04/08)

RECEIVED


APR 26 2013

BY: OLWR

The sketch below only required for water wells


Description of formations encountered must be provided for all wells and boreholes, unless specifically exempted by regulations

If well telescopes, show depths on sketch.

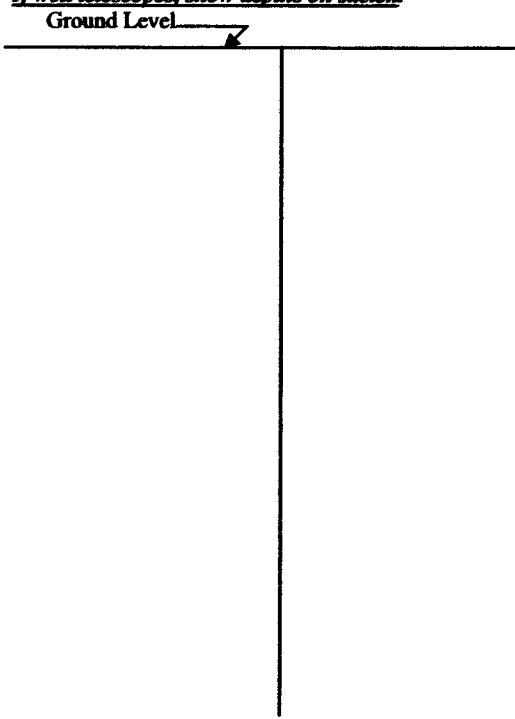

Description of Formations Encountered	From (depth) Ground Level	To (depth)
white sand	0	50

If more than one screen, show location of each on sketch

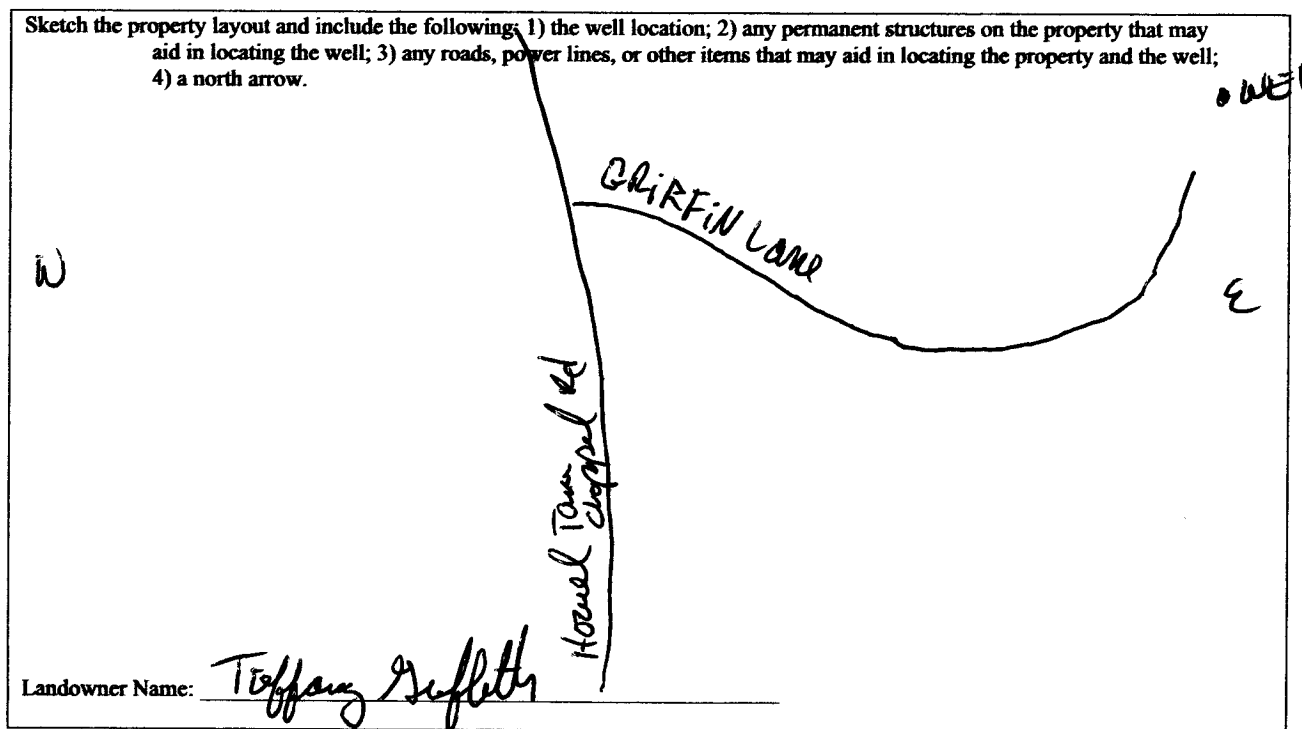

Form: OLWR-SWR-1A (04/08)

I certify that the well/borehole was drilled, constructed, and completed in accordance with all applicable requirements of the Mississippi Department of Environmental Quality and the Mississippi Department of Health regulations, if applicable, and state laws.

Joel Pier     0-780     4-18-13

Joel Pier  
Signature of Licensee

RECEIVED

APR 26 2013

BY: OLWR

# STATE WELL REPORT

## Part 2

**Pump Installer's Completion Report**  
 Mississippi Department of Environmental Quality  
 Office of Land and Water Resources  
 P.O. Box 2309  
 Jackson, MS 39225  
 (601)961-5210  
 (601)961-5228 (fax)

County: George  
 Permit #: 0-780  
 Driller: J. Pierce  
 Date completed: 4-18-13  
Copy information from block on Part 1

**For Office Use Only:**

Aquifer: \_\_\_\_\_  
 Well #: M221  
 Elevation: \_\_\_\_\_

*This part of the report must be completed by a licensed water well contractor or a licensed pump installer. A copy of Part 1 of the report must be attached and both parts filed with the Department at the above address within 30 days of well completion.*

Well Owner Information	Well Location
Owner Name: <u>Tiffany Griffith</u>	Latitude: <u>30-44-131</u> Longitude: <u>88-27-171</u>
Mailing Address: <u>131 Griffith Lane</u>	Method of Lat/Long (check one): Conventional Survey _____
<u>Uxbridge</u> <u>MS</u> <u>39452</u>	USGS quad _____, Hand-held GPS <input checked="" type="checkbox"/> , Survey-grade GPS _____
City State Zip Code	<u>NW</u> 1/4 <u>NE</u> 1/4 Sec <u>35</u> T <u>135</u> R <u>5W</u>
Telephone No. <u>(228) 219-1313</u>	Distance _____ Miles Direction <u>east</u> of Nearest Town <u>Agula, MS</u>

Pump Type Circle one	Power Type Circle one
Air Lift <input type="checkbox"/> Jet <input checked="" type="checkbox"/> Submersible <input type="checkbox"/>	Diesel Engine <input type="checkbox"/> Gasoline Engine <input type="checkbox"/> Natural Gas <input type="checkbox"/>
Bucket <input type="checkbox"/> Piston <input type="checkbox"/> Turbine <input type="checkbox"/>	<input checked="" type="checkbox"/> Electric Motor <input type="checkbox"/> Hand <input type="checkbox"/> Tractor PTO <input type="checkbox"/>
Centrifugal <input type="checkbox"/> Rotary <input type="checkbox"/> Flowing Well <input type="checkbox"/>	Windmill <input type="checkbox"/> Other (specify): _____
Other (specify): _____	Horse Power Rating of Motor: <u>1</u>
Date Pump Installed: <u>4-18-13</u>	Setting Depth: <u>25 set line</u> feet
Rated Pump Capacity: <u>10</u> Gallons Per Minute	Number of Stages: <u>2</u>

Pump Test Data	Method of Measuring Water Level Circle one
Date Well Tested: <u>4-18-13</u>	<input checked="" type="checkbox"/> Air Line <input type="checkbox"/> Electric Measuring Line <input type="checkbox"/> Steel Tape
Static Water Level (A): <u>3</u> Feet Below Land Surface	Other (specify): _____
Pumping Water Level (B): <u>20</u> Feet Below Land Surface	For flowing well, measured shut in head: _____ feet
Drawdown [(B) - (A)]: <u>2</u> Feet Below Land Surface	Well yielded <u>10</u> GPM with a drawdown of
Test Pumping Rate: <u>10</u> Gallons Per Minute	<u>2</u> feet after <u>48</u> hours of pumping
Duration of Pump Test (minimum 4 hours): <u>48</u> hours	

This is for (circle one):  **New Well**  Replacement of Existing Pump  Repair of Existing Pump

I HEREBY CERTIFY that the above statements are true to the best of my knowledge.

JOEL PIERCE 0-780 Joel Pierce  
 Print Name of Pump Installer and License No. (if applicable) Signature of Pump Installer

**RECEIVED**

APR 26 2013

Form: OLWR-SWR-1C(07)WR