county: George	STATE WELL REPORT			
	Part 1	For Office Use Only:		
Permit #:	Driller's Log Mississippi Department of Environmental Quali	well #: <u>M 223</u>		
Driller: Michael S. Havard	Office of Land and Water Resources	Aquifer:		
Date drilling completed: <u>\\-05-2013</u>	P.O. Box 2309 Jackson, MS 39225-2309	E-Log #:		
	(601)961-5210			
	(601)360-0535 (fax)			
4 4	be prepared by the license holder responsible fo within 30 days of completion of drilling of the wa	-		
Well Owner Informat	ion Well or B	orehole Location		
(Landowner if borehole is not for	Latitude: 36 49 44.71 N	Latitude: 30 48 44.7 1 Longitude: 88 31 20.33 い		
Owner Name: Brad Soloma	<u>n</u>			
Mailing Address: 153 Hascal (Sunter RA	one): Conventional Survey		
		USGS quad, Hand-held GPS, Survey-grade GPS		
Lucidale MS	3945-2 NG 4 5W 4, 50	ec. L. T. T35 R. R.S.		
City State	Zip Code V2 Miles N	of Ancicala		
Telephone No. ()				
	Well / Borehole Data			
N	Electric Gamma Ray Density Sonic New			
Logs run (circle all applicable): No log r	un Electric Gamma Ray Density Sonic New	utron Other:		
Logs run (circle all applicable): No log r		utron Other:		
Logs run (circle all applicable): No log r Name of organization running log(s):	Well Geotechnical/Geological Investigation	utron Other: Ground Source Heat Pump		
Logs run (circle all applicable): No log r Name of organization running log(s): _ Purpose of borehole (circle one): Water Seism	Well Geotechnical/Geological Investigation	utron Other: Ground Source Heat Pump		
Logs run (circle all applicable): No log r Name of organization running log(s): _ Purpose of borehole (circle one); water Seism If drilling is not rel	Well Geotechnical/Geological Investigation	utron Other: Ground Source Heat Pump der of this block		
Logs run (<i>circle all applicable</i>): No log r Name of organization running log(s): Purpose of borehole (<i>circle one</i>); Water Seism <i>If drilling is not rel</i> Purpose of Well (<i>circle all applicable</i>)	Well Geotechnical/Geological Investigation ic Survey Other (describe) ated to water well construction, skip the remain	utron Other: Ground Source Heat Pump der of this block		
Logs run (circle all applicable): No log r Name of organization running log(s): Purpose of borehole (circle one): Water Seism <i>If drilling is not rel</i> Purpose of Well (circle all applicable) Other (describe):	Well Geotechnical/Geological Investigation ic Survey Other (describe) ated to water well construction, skip the remain Home Industrial	utron Other: Ground Source Heat Pump <i>der of this block</i> Fish Culture		
Logs run (circle all applicable): No log r Name of organization running log(s): Purpose of borehole (circle one): Water <i>If drilling is not rel</i> Purpose of Well (circle all applicable) Other (<i>describe</i>): If a flowing well, method of flow regul	Well Geotechnical/Geological Investigation ic Survey Other (describe) ated to water well construction, skip the remain Home Industrial	utron Other: Ground Source Heat Pump <i>der of this block</i> Fish Culture		
Logs run (circle all applicable): No log r Name of organization running log(s): Purpose of borehole (circle one): Water <i>If drilling is not rel</i> Purpose of Well (circle all applicable) Other (<i>describe</i>): If a flowing well, method of flow regul Static Water Level: 28 'feet	Well Geotechnical/Geological Investigation ic Survey Other (describe) ated to water well construction, skip the remain Home Industrial Public Supply Irrigation ation: Valve Cabove or (describe) Cabove or (describe)	utron Other: Ground Source Heat Pump der of this block Fish Culture ured: <u>]]-05-2013</u>		
Logs run (<i>circle all applicable</i>): No log r Name of organization running log(s): Purpose of borehole (<i>circle one</i>): Water <i>If drilling is not rel</i> Purpose of Well (<i>circle all applicable</i>) Other (<i>describe</i>): If a flowing well, method of flow regul Static Water Level: Method of measurement (<i>circle one</i>): S	Well Geotechnical/Geological Investigation ic Survey Other (describe) ated to water well construction, skip the remain Home Industrial Public Supply Irrigation ation: Valve Other (describe) Other (describe) Industrial Public Supply Irrigation Other (describe) Industrial	utron Other: Ground Source Heat Pump der of this block Fish Culture ured: <u>]]- 05 - 2013</u> be):		
Logs run (<i>circle all applicable</i>): No log r Name of organization running log(s): Purpose of borehole (<i>circle one</i>): Water <i>If drilling is not rel</i> Purpose of Well (<i>circle all applicable</i>) Other (<i>describe</i>): If a flowing well, method of flow regul Static Water Level: Method of measurement (<i>circle one</i>): S Well depth: _74.' Well grouted to a	Well Geotechnical/Geological Investigation ic Survey Other (describe) ated to water well construction, skip the remain Home Industrial Public Supply Irrigation ation: Valve Geotechnical/Geological Investigation Other (describe) Industrial Public Supply Industrial Other (describe) Other (describe) Industrial Other (describe) Industrial Public Supply Industrial Other (describe) Industrial Other (describe) Industrial Industrial Other (describe) Industrial Industrial Industrial Industrial Industrial Industrial Industrial Industrial Industrial Indust	utron Other: Ground Source Heat Pump der of this block Fish Culture ured: <u> -05-2013</u> be): he): Neat Cement Bentonite		
Logs run (<i>circle all applicable</i>): No log r Name of organization running log(s): Purpose of borehole (<i>circle one</i>): Water <i>If drilling is not rel</i> Seism <i>If drilling is not rel</i> Purpose of Well (<i>circle all applicable</i>) Other (<i>describe</i>): Other (<i>describe</i>): If a flowing well, method of flow regul Static Water Level: 28' feet Method of measurement (<i>circle one</i>): S Well depth: Well grouted to a Casing length: feet Ca	Well Geotechnical/Geological Investigation ic Survey Other (describe) ated to water well construction, skip the remain ated to water well construction, skip the remain Industrial Public Supply Industrial Public Supply ation: Valve Other (describe) Iand surface Date measu (circle one) Air line Other (describe) iteel tape Electric tape Air line depth of: 12' feet Type of grout (circle on asing diameter: asing diameter: 4'' inches Type	utron Other: Ground Source Heat Pump der of this block Fish Culture ured: 11-05-2013 be): he): Meat Cement Bentonite Mix of casing: PUL SHO BE of screen: MIX WAP		
Logs run (<i>circle all applicable</i>): No log r Name of organization running log(s): Purpose of borehole (<i>circle one</i>): Water <i>If drilling is not rel</i> Seism <i>If drilling is not rel</i> Purpose of Well (<i>circle all applicable</i>) Other (<i>describe</i>): Other (<i>describe</i>): If a flowing well, method of flow regul Static Water Level: 28' feet Method of measurement (<i>circle one</i>): S Well depth: Well grouted to a Casing length: feet Ca	Well Geotechnical/Geological Investigation ic Survey Other (describe) ated to water well construction, skip the remain ation: Industrial Public Supply Irrigation ation: Valve	utron Other: Ground Source Heat Pump der of this block Fish Culture ured: 11-05-2013 be): he): Meat Cement Bentonite Mix of casing: PUL SHO BE of screen: MIX WAP		
Logs run (<i>circle all applicable</i>): No log r Name of organization running log(s): Purpose of borehole (<i>circle one</i>): Water <i>If drilling is not rel</i> Seism <i>If drilling is not rel</i> Purpose of Well (<i>circle all applicable</i>) Other (<i>describe</i>): Other (<i>describe</i>): If a flowing well, method of flow regul Static Water Level: 28' feet Method of measurement (<i>circle one</i>): S Well depth: Well grouted to a Casing length: feet Ca	Well Geotechnical/Geological Investigation ic Survey Other (describe) ated to water well construction, skip the remain Home Industrial Public Supply Irrigation ation: Valve Other (describe) ation: Valve Other (describe) Iand surface Date measu (circle one) Air line Other (describe) iteel tape Electric tap Air line Other (describe) depth of: 12' feet Type of grout (circle on asing diameter: inches Type Setting depth: From feet Type	Ground Source Heat Pump der of this block Fish Culture ured: <u>11-05-2013</u> be): he): Neat Cement Bentonite Mix of casing: <u>PVL S40 BE</u> of screen: <u>PVL S40 BE</u>		
Logs run (<i>circle all applicable</i>): No log r Name of organization running log(s): Purpose of borehole (<i>circle one</i>): Water <i>If drilling is not rel</i> Purpose of Well (<i>circle all applicable</i>) Other (<i>describe</i>): If a flowing well, method of flow regul Static Water Level: Method of measurement (<i>circle one</i>): S Well depth: Well grouted to a Casing length: feet Screen length: feet Screen slot size: feet Type of completion (<i>circle all applicable</i>)	Well Geotechnical/Geological Investigation ic Survey Other (describe) ated to water well construction, skip the remain Home Industrial Public Supply Irrigation ation: Valve Other (describe) ation: Valve Other (describe) Iand surface Date measu (circle one) Air line Other (describe) iteel tape Electric tap Air line Other (describe) depth of: 12' feet Type of grout (circle on asing diameter: inches Type Setting depth: From feet Type	utron Other: Ground Source Heat Pump der of this block Fish Culture ured: $11-05-2013$ be): he): Neat Cement Bentonite Mix of casing: $PVL S40$ BE of screen: $PVL S40$ BE to $_7L^1$ feet		
Logs run (<i>circle all applicable</i>): No log r Name of organization running log(s): Purpose of borehole (<i>circle one</i>): Water <i>If drilling is not rel</i> Purpose of Well (<i>circle all applicable</i>) Other (<i>describe</i>): If a flowing well, method of flow regul Static Water Level: Method of measurement (<i>circle one</i>): S Well depth: Well grouted to a Casing length: feet Screen length: feet Screen slot size: feet Type of completion (<i>circle all applicable</i>)	Well Geotechnical/Geological Investigation inc Survey Other (describe) ated to water well construction, skip the remain Home Industrial Public Supply Irrigation ation: Valve Other (describe) ation: Valve Other (describe) Iand surface Date measu (circle one) Air line Other (describe) iteel tape Electric tap Air line Other (describe) depth of: 12' feet Type of grout (circle on asing diameter:	utron Other: Ground Source Heat Pump der of this block Fish Culture ured: 11-05-2013 be):		


Form: OLWR-SWR-1A (4/13)

County: _	George
•	1
Permit #:	

For	Of	fice	Use	Only:
Well #:	И	22	3	

The sketch below only required for water wells

If well telescopes, show depths on sketch.

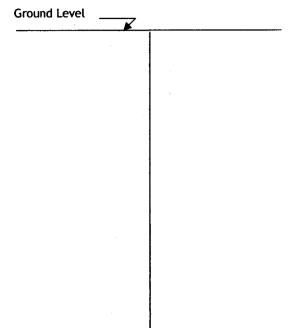

Description of formations encountered must be provided for all wells and boreholes, unless specifically exempted by regulations

Description of Formations Encountered	From (depth)	To (depth)
Topsand	Ground level	13,
Class	12,	18,
silt	/8'	21'
Sand/ clau Strips	21'	38'
Sandi fine = mid	38'	48'
Sandi med	48'	76'
•		

If more than one screen, show location of each on sketch

Sketch the property layout and include the following:

1) the well location

2) any permanent structures on the property that may aid in locating the well

3) any roads, power lines, or other items that may aid in locating the property and the well

4) north arrow	in locating the property and the wett	
		1
à	= لا	
		1 T T
	F* \$	
	Hoscal Gunter Rd	
Landowner Name: Brad Soloman		
I HEREBY CERTIFY that the well/borehole was drilled requirements of the Mississippi Department of Enviro	d, constructed, and completed in accordar onmental Quality and the Mississippi Depar	ice with all applicable tment of Health regulations,
if applicable, and state laws.	alla	M I
Michael S. Havard 0-673 Print Name of Responsible Licensee and License No.	<u>R-03-2013</u> Date Signatu	Ire of Licensee

	STATE W	ELL REPORT		
County: <u>George</u> Permit #: Driller: Michael S. Havard	Part 2 Pump Installer's Completion Report Mississippi Department of Environmental Quality Office of Land and Water Resources		For Office Use Only: wett #:	
Date completed: <u>11-05-2013</u> Copy information from block on Part 1	Jackso (I	.O. Box 2309 n, MS 39225-2309 501)961-5210) 360-0535 (fax)	Aquifer:	
This part of the report must be complete of the report must be attached and both Well Owner Informati	parts filed with the L	epartment at the above address w	np installer. A copy of Part 1 vithin 30 days of well completion. ocation	
Owner Name: Brad Soloman Mailing Address: Hascal Gunter	1	Latitude: <u>30°48'44.74"</u> Lon Method of Lat/Long (<i>check one</i>)		
Lucch MS City State Telephone No. (<u>LOI</u>)	34452 Zip Code		PS, Survey-grade GPS (Γ_T3SR_KSω) Aqricala (Nearest Town)	
	Pump Typ	e (circle one)		
Submersible Turbine Air Lift Centrifugal Flowing Well Jet Piston Rotary Other (describe):				
Static Water Level (A): <u>28'</u> Feet Drawdown [(B) - (A)]: <u>17'</u> F				
Method of measurement (circle one): Ste		Air line Other (describe): Ta for Flowing Well		
Measured shut in head:feet. Well yieldedGPM with a d	-	-	hours of pumping	
Meter Installation				
Meter Manufacturer:		Meter Serial Number:		
Meter Model Number/Name:		Type of Meter:		
Totalizer Register Unit and Multiplier Factor (AF x .001, gal x 1000, etc):				
	weter installed by:			
ls This Meter (circle one): New Rep Important: By submitting the above inf For agricultur	ormation you are ce		led to manufacturer standards. bsite.	
I HEREBY CERTIFY that the above statem Michael S. Havard O-C Print Name of Pump Installer and License		/	ure of Pump Installer	