


George
M 2048

MISSISSIPPI DEPARTMENT OF NATURAL RESOURCES
Bureau of Land and Water Resources
Southport Mall
P.O. Box 10631
Jackson, Mississippi 39209
WATER WELL DRILLERS LOG

10-11 1986 St. Peter Drilling Co. George
date well completed firm name county well located

LANDOWNER: <u>Murray Cowart</u>	description of formations encountered	from	to
<u>Rt 1 Box 714</u>			
<u>Lucedale, MS</u> (mailing address)	<u>Top Soil</u>	<u>0</u>	<u>10</u>
	<u>Clay</u>	<u>10</u>	<u>15</u>
	<u>Sand</u>	<u>15</u>	<u>25</u>
WELL LOCATION:	<u>Clay</u>	<u>25</u>	<u>300</u>
<u>sec. 22 T 3 N R 5 E</u>	<u>Good Sand</u>	<u>300</u>	<u>315</u>
<u>5</u> miles <u>South</u> of <u>Lucedale</u>			
(distance) (direction) (nearest town)			
WELL PURPOSE: (<u>Home</u>) Irrigation, municipal, industrial)			
WELL COMPLETION DATA:			
(1) diameter (inches) <u>2"</u>			
(2) total depth (feet) <u>315'</u>			
(3) static water level (feet) <u>75'</u> <u>below</u> above top of ground.			
(4) casing <u>plastic, 305'</u> (material) (depth)			
<u>0</u> If telescope see back. (size)			
(5) screen <u>10'</u> , <u>315'</u> (length) (depth to top)			
<u>006</u> , <u>plastic</u> (size) (material)			
(6) pump <u>1</u> <u>8</u> (HP) (yield gpm)			
<u>electric</u> (type power)			
(7) electric log <u>(yes or no)</u>			
(organization running log)			
(8) how well bottom plugged <u>BW</u>			
DRILLERS REMARKS:			

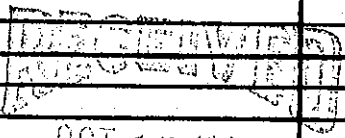

OCT 15 1986

Department of Natural Resources
Bureau of Land & Water Resources