

George
M 2087
5-7-81

MISSISSIPPI
BOARD OF WATER COMMISSIONERS
416 North State Street
Jackson, Mississippi 39201

WATER WELL DRILLERS LOG

George
county well located

5/7/81 date well completed
81 Cecil S. Howell firm name
Service

LANDOWNER: Harry Thekuma
Lucedale Miss

description of formations encountered	from	to
Dirt	0	2
Red dirt	2	6
Red clay	6	17
Sand	17	28


(mailing address)

WELL LOCATION:
sec. 17 T. 3 N R. 5 E
1 miles (distance) N Travella (direction) (nearest town)

WELL PURPOSE: Home
(home, irrigation, municipal, industrial)

WELL COMPLETION DATA:

- (1) diameter (inches) 2 1/2
- (2) total depth (feet) 28
- (3) static water level (feet) 16 below top of ground
- (4) casing Plastic 28 (material) (depth)
- (size) if telescope see back.
- (5) screen 5 ft 23 (length) (depth to top)
- 2 1/2 Plastic (size) (material)
- (6) pump Electric (type power) (yield/gpm)
- (7) electric log (yes or no)

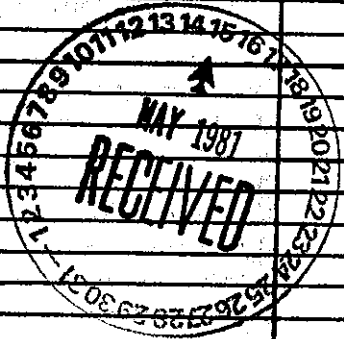

(organization running log)
(8) how well bottom plugged Back Wash valve

DRILLERS REMARKS: