

George
M 2088
5-4-81

MISSISSIPPI
BOARD OF WATER COMMISSIONERS
416 North State Street
Jackson, Mississippi 39201

WATER WELL DRILLERS LOG

George
county well located

5/4/81 1981 Cecil S. Howell's Well Service
date well completed firm name

LANDOWNER: Lydie Fritwell
Lucedale, Miss

description of formations encountered	from	to
Dirt	0	2
Red Dirt	2	10
Red Clay	10	19
Dark Sand	19	25
Yellow Clay	25	31
Sand	31	57

(mailing address)


WELL LOCATION:

sec 17 T 3 N R 5 E
1 miles N of Dandella
(distance) (direction) (nearest town)

WELL PURPOSE: Home
(home, irrigation, municipal, industrial)

WELL COMPLETION DATA:

- (1) diameter (inches) 2 1/2
- (2) total depth (feet) 57
- (3) static water level (feet) 30 below top of ground
- (4) casing Plastic 57 (material) (depth)
- (5) screen 57 52 (length) (depth to top)
- (6) pump Electric (type power) (yield gpm)
- (7) electric log (yes or no)

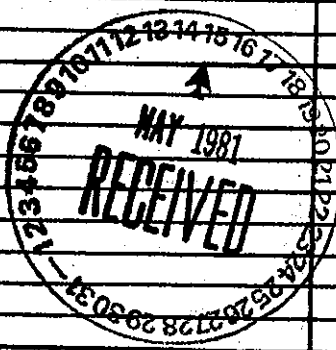

(organization running log)

(8) how well bottom plugged? Wash water

DRILLERS REMARKS: