

Not in USGS database *CP 10/07*

GREENE MISSISSIPPI BOARD OF WATER COMMISSIONERS

A

6

WATER WELL DRILLERS LOG

9-64

Date: *Sept*, 19*64*, Driller: *Peoples Dully County Greene*
(Name)

(1) Owner of Land:	Description & Color of Materials Sand, Clay, Red Clay, Shell, etc.	Thick- ness Feet	Depth Feet
<i>Judge Beulah Felt</i> (Name) <i>Richton</i> (Address)	<i>Yellow clay & sandy clay</i>	<i>42</i>	<i>42</i>
(2) Location: $\frac{1}{4}$, $\frac{1}{4}$, Sec. <i>10</i> T. <i>5N</i> R. <i>2E</i> <i>10</i> miles <i>NF</i> of <i>Richton</i> (distance) (direction) (Nearest Town)	<i>Blue shale & sandy shale</i>	<i>176</i>	<i>218</i>
(3) Topography: <i>Hilly</i> (Hilly) (Flat) (Level)	<i>White sand</i>	<i>34</i>	<i>252</i>
(4) Purpose of Well: <i>Home</i> (Domestic Irrigation Municipal, Industrial, Other)	<i>Gray sandy shale</i>	<i>84</i>	<i>336</i>
	<i>White sand & shale</i>	<i>31</i>	<i>367</i>
	<i>White sand</i>	<i>42</i>	<i>409</i>


Information upon completion of well:

- (1) Diameter *2* inches.
- (2) Total Depth *409* feet.
- (3) Water Level *115* feet below top of ground.
- (4) Cased to *#03*, Size *2"*
- (5) Screen: Size *2"*, Length *6"*
- (6) Were any formations sealed against pollution?
_____yes, _____no.

If YES depth of formation _____

Why _____

Drillers Remarks: _____

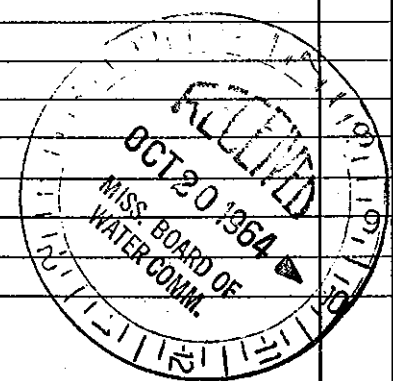

(Use Back Side)

Well No.

Mail this copy to Board of Water Commissioners 429 Miss. St. Jackson, Miss.