

GREENE MISSISSIPPI BOARD OF WATER COMMISSIONERS

A 25 **3** **USGS**
10-64 **10/1/69**
WATER WELL DRILLERS LOG

Date: Oct, 1964, Driller: People Drilling Co County Greene
 (Name)

(1) Owner of Land: <u>E. Thidige Brewer</u> (Name)	Description & Color of Materials Sand, Clay, Red Clay, Shell, etc.	Thick- ness Feet	Depth Feet
<u>Richton</u> (Address)	<u>Clay & Sandy clay</u>	<u>21</u>	<u>21</u>
(2) Location: <u>NE 1/4, NE 1/4, Sec. 8 T. 5 N. R. 10 W.</u>	<u>Blue marl</u>	<u>11</u>	<u>32</u>
<u>12 miles NE</u> of <u>Richton</u> (distance) (direction) (Nearest Town)	<u>Blue marl & white sandstone</u>	<u>31</u>	<u>63</u>
(3) Topography: <u>Hilly</u> (Hilly) (Flat) (Level)	<u>Blue shale</u>	<u>73</u>	<u>136</u>
(4) Purpose of Well: <u>Home</u> (Domestic Irrigation Municipal, Industrial, Other)	<u>Blue sandy shale</u>		
	<u>Small sand shell</u>	<u>128</u>	<u>264</u>
	<u>White sand</u>	<u>30</u>	<u>294</u>


Information upon completion of well:

- (1) Diameter 2 inches.
- (2) Total Depth 294 feet.
- (3) Water Level 130 feet below top of ground.
- (4) Cased to 288", Size 2"
- (5) Screen: Size 2", Length 4'
- (6) Were any formations sealed against pollution?
 yes, no.

If YES depth of formation _____

Why _____

Drillers Remarks: _____

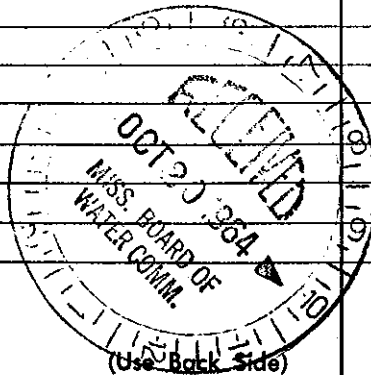

Well No. _____