

GREENE MISSISSIPPI BOARD OF WATER COMMISSIONERS

A-259
8-64

WATER WELL DRILLERS LOG

Date: Aug, 1964, Driller: Peoples Drilling Co. County Greene
(Name)

(1) Owner of Land: <u>Miss Brewer</u> (Name)	Description & Color of Materials Sand, Clay, Red Clay, Shell, etc.	Thick- ness Feet	Depth Feet
<u>Rt 1 Richlon Miss</u> (Address)	<u>Yellow Sandy clay</u>	<u>31</u>	<u>31</u>
(2) Location: <u>1 1/4, 1 1/4, Sec. 9 SW 1/4</u>	<u>Yellow Sand</u>	<u>8</u>	<u>39</u>
<u>11 miles NE</u> of <u>Richlon</u> (distance) (direction) (Nearest Town)	<u>Blue marl</u>	<u>55</u>	<u>94</u>
(3) Topography: <u>Hilly</u> (Hilly) (Flat) (Level)	<u>Blue Fine Sand</u>	<u>12</u>	<u>106</u>
(4) Purpose of Well: <u>Home</u> (Domestic Irrigation Municipal, Industrial, Other)	<u>Blue Stomach</u>	<u>93</u>	<u>199</u>
	<u>Blue sandy stone</u>		
	<u>4 small sandstone</u>	<u>137</u>	<u>336</u>
	<u>White Sand & shale</u>	<u>21</u>	<u>357</u>
	<u>White sand</u>	<u>48</u>	<u>405</u>


Information upon completion of well:

- (1) Diameter 2 inches.
- (2) Total Depth ~~405~~ 405 feet.
- (3) Water Level 90 feet below top of ground. 399
- (4) Cased to ~~357~~, Size 2"
- (5) Screen: Size 2", Length 6'
- (6) Were any formations sealed against pollution?
_____ yes, _____ no.

If YES depth of formation _____

Why _____

Drillers Remarks: _____

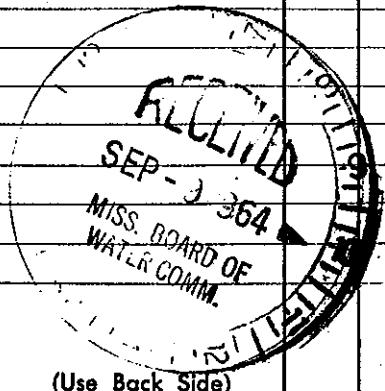

(Use Back Side)

Well No.

Mail this copy to Board of Water Commissioners 429 Miss. St. Jackson, Miss.