

GREENE

MISSISSIPPI BOARD OF WATER COMMISSIONERS

A 22
10-65

(6)

WATER WELL DRILLERS LOG

Date: Oct., 1965, Driller: Peoples Drilling Co County Greene
(Name)

	Description & Color of Materials Sand, Clay, Red Clay, Shell, etc.	Thick- ness Feet	Depth Feet
(1) Owner of Land: <u>Johnny Brewer</u> (Name)	<u>White Clay</u>	<u>35</u>	<u>35</u>
<u>Rt 1 Richton</u> (Address)	<u>Blue shale + sand streak</u>	<u>70</u>	<u>105</u>
(2) Location: <u>1/4, 1/4, Sec. 29 T5N R8W</u>	<u>White sand</u>	<u>10</u>	<u>115</u>
<u>8 miles E</u> , of <u>Richton</u> (distance) (direction) (Nearest Town)	<u>Blue sandy shale</u>	<u>105</u>	<u>210</u>
(3) Topography: <u>Hilly</u> (Hilly) (Flat) (Level)	<u>White sand + shale</u>	<u>42</u>	<u>252</u>
(4) Purpose of Well: <u>Home</u> (Domestic Irrigation Municipal, Industrial, Other)	<u>streaks</u>	<u>63</u>	<u>315</u>
	<u>Blue shale</u>	<u>42</u>	<u>357</u>
	<u>White sand + shale</u>	<u>32</u>	<u>389</u>
	<u>Coarse white sand</u>		


Information upon completion of well:

- (1) Diameter 2 inches.
- (2) Total Depth 389 feet.
- (3) Water Level 110 feet below top of ground.
- (4) Cased to 383', Size 2"
- (5) Screen: Size 2", Length 6'
- (6) Were any formations sealed against pollution?
_____yes, _____no.

If YES depth of formation _____

Why _____

Drillers Remarks: _____

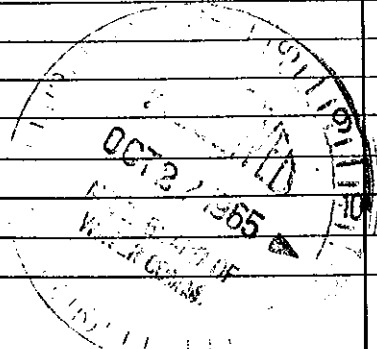

(Use Back Side)

Well No.

Mail this copy to Board of Water Commissioners 429 Miss. St. Jackson, Miss.