

GREENE

MISSISSIPPI BOARD OF WATER COMMISSIONERS

A 24

(6)

WATER WELL DRILLERS LOG

Greene Co. 2
A or B?

12-20-60

Date: 12/20, 1960, Driller: David Newell
County: Leflore

(Name)

(1) Owner of Land: <small>(Name)</small>	Description & Color of Materials <small>Sand, Clay, Red Clay, Shell, etc.</small>	Thick- ness Feet	Depth Feet
land Hill School <small>(Address)</small> Buckton Miss.	clay sand	0 4 1/2	40 63
(2) Location: 1/4, 1/4, Sec. 33 T ²⁰ R ^{8W}			
10 miles E of Buckton <small>(distance) (direction) (Nearest Town)</small>			
(3) Topography: Hilly <small>(Hilly) (Flat) (Level)</small>			
(4) Purpose of Well: for school <small>(Domestic Irrigation Municipal, Industrial, Other)</small>			

Hole depth
63
Well depth
60


Information upon completion of well:

- (1) Diameter 4 1/2 inches.
- (2) Total Depth 63 feet.
- (3) Water Level 30 feet below top of ground.
- (4) Cased to 55 ft. Size 2 in.
- (5) Screen: Size 2 in., Length 5 ft.
- (6) Were any formations sealed against pollution?
 yes, no.

If YES depth of formation clay

Why clay was hard

Drillers Remarks:

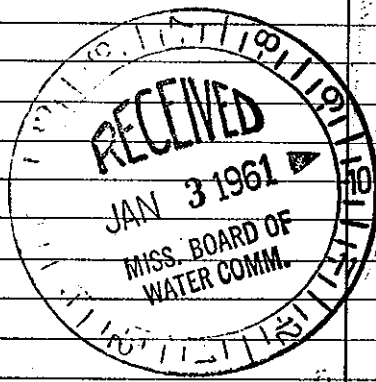

(Use Back Side)

Well No.

Mail this copy to Board of Water Commissioners 429 Miss. St. Jackson, Miss.