

GREENE MISSISSIPPI BOARD OF WATER COMMISSIONERS

A 25
8-64

6

WATER WELL DRILLERS LOG

Date: Aug., 1964, Driller: People Drilling Co County Greene
(Name)

(1) Owner of Land:	Description & Color of Materials Sand, Clay, Red Clay, Shell, etc.	Thick- ness Feet	Depth Feet
<u>Lee Bremer</u> (Name) <u>R.T.1, Richter</u> (Address)	<u>yellow sandy clay</u>	<u>21</u>	<u>21</u>
(2) Location: <u>1/4</u> , <u>1/4</u> , Sec. <u>34</u> T <u>5</u> R <u>8</u> W	<u>blue clay</u>	<u>24</u>	<u>45</u>
<u>11</u> miles <u>E</u> of <u>Richter</u> (distance) (direction) (Nearest Town)	<u>white sand</u>	<u>10</u>	<u>55</u>
(3) Topography: <u>Hilly</u> (Hilly) (Flat) (Level)	<u>blue sandy shale</u>	<u>92</u>	<u>147</u>
(4) Purpose of Well: <u>Home</u> (Domestic Irrigation Municipal, Industrial, Other)	<u>blue sandy shale</u>	<u>73</u>	<u>220</u>
	<u>small sand streak</u>	<u>13</u>	<u>233</u>
	<u>fine white sand</u>	<u>103</u>	<u>336</u>
	<u>gray shale</u>	<u>10</u>	<u>346</u>
	<u>blue sandy shale</u>	<u>22</u>	<u>368</u>
	<u>white sand</u>		


Information upon completion of well:

- (1) Diameter 2 inches.
- (2) Total Depth 368 feet.
- (3) Water Level 85 feet below top of ground.
- (4) Cased to 362', Size 2"
- (5) Screen: Size 2", Length 6'
- (6) Were any formations sealed against pollution?
_____ yes, _____ no.

If YES depth of formation _____

Why _____

Drillers Remarks: _____

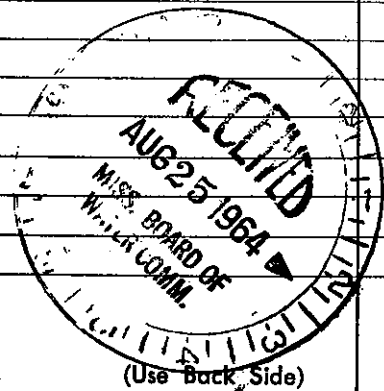

Well No. _____

Mail this copy to Board of Water Commissioners 429 Miss. St. Jackson, Mis: