

A 28  
10-64

WATER WELL DRILLERS LOG


Date: Oct, 1964, Driller: Peoples Drilling Co County Greene  
(Name)

		Description & Color of Materials Sand, Clay, Red Clay, Shell, etc.	Thick- ness Feet	Depth Feet
(1) Owner of Land:	<u>McLain</u> (Name)	<u>yellow sand &amp;</u>		
	<u>Richland, Miss</u> (Address)	<u>small clay streak</u>	<u>73</u>	<u>73</u>
(2) Location:	<u>1/4</u> , <u>5N 5W</u> , <u>5</u> T, <u>RD</u> Sec.	<u>blue clay</u>	<u>32</u>	<u>105</u>
	<u>12</u> miles <u>E</u> , of <u>Richland</u> (distance) (direction) (Nearest Town)	<u>soft blue sandy</u>		
(3) Topography:	<u>Hilly</u> (Hilly) (Flat) (Level)	<u>strata &amp; sand streak</u>	<u>115</u>	<u>220</u>
(4) Purpose of Well:	<u>Home</u> (Domestic Irrigation Municipal, Industrial, Other)	<u>blue sandy strata</u>	<u>32</u>	<u>252</u>
		<u>soft sandy strata</u>		
		<u>&amp; small sand streak</u>	<u>140</u>	<u>412</u>
		<u>white sand</u>	<u>35</u>	<u>447</u>

Information upon completion of well:

- (1) Diameter 2 inches.
- (2) Total Depth 447 feet.
- (3) Water Level 155 feet below top of ground.
- (4) Cased to 441', Size 2'
- (5) Screen: Size 2", Length 6'
- (6) Were any formations sealed against pollution?  
\_\_\_\_\_ yes, \_\_\_\_\_ no.
- If YES depth of formation \_\_\_\_\_
- Why \_\_\_\_\_

Drillers Remarks:

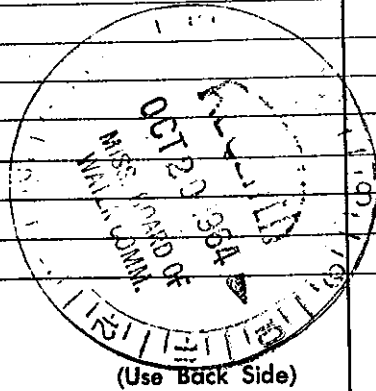

(Use Back Side)

Well No.