

GREENE MISSISSIPPI BOARD OF WATER COMMISSIONERS

A 29 6

4-65

WATER WELL DRILLERS LOG

Date: April, 1965, Driller: Paper Drilling Co County Greene
(Name)

		Description & Color of Materials Sand, Clay, Red Clay, Shell, etc.	Thick- ness Feet	Depth Feet
(1) Owner of Land:	<u>Mills</u> (Name)	<u>yellow sand</u>	<u>15</u>	<u>15</u>
	<u>Richton</u> (Address)	<u>white clay</u>	<u>25</u>	<u>40</u>
(2) Location:	<u>3/4</u> , <u>3/4</u> , Sec. <u>35</u> T. <u>5</u> R. <u>10</u>	<u>Blue shale</u>		
	<u>12</u> miles <u>E</u> of <u>Richton</u> (distance) (direction) (Nearest Town)	<u>sandy shale</u>	<u>10</u>	<u>147</u>
(3) Topography:	<u>Hilly</u> (Hilly) (Flat) (Level)	<u>brown sandy shale</u>	<u>13</u>	<u>160</u>
(4) Purpose of Well:	<u>Home</u> (Domestic Irrigation Municipal, Industrial, Other)	<u>fine sand & shale</u>	<u>71</u>	<u>231</u>
		<u>Blue shale</u>	<u>84</u>	<u>315</u>
		<u>white sand</u>	<u>63</u>	<u>378</u>


Information upon completion of well:

- (1) Diameter 2 inches.
- (2) Total Depth 378 feet.
- (3) Water Level 100 feet below top of ground.
- (4) Cased to 372', Size 2"
- (5) Screen: Size 2", Length 6'
- (6) Were any formations sealed against pollution?
_____ yes, no.

If YES depth of formation _____

Why _____

Drillers Remarks: _____

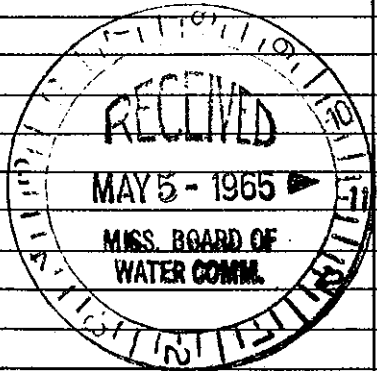

Well No.

(Use Back Side)

File this copy to Board of Water Commissioners 429 Miss. St. Jackson, Miss.