

GREENE MISSISSIPPI BOARD OF WATER COMMISSIONERS


A 30 ⑥

4-65

WATER WELL DRILLERS LOG

Date: April, 1965, Driller: Peoples Drilling Co County Greene
Stimpson(s) (Name)

(1) Owner of Land: <u>William Stinson</u> (Name)	Description & Color of Materials Sand, Clay, Red Clay, Shell, etc.	Thick- ness Feet	Depth Feet
<u>Rt 1 Box 121 Richton</u> (Address)	<u>Yellow sandy clay</u>	<u>21</u>	<u>26</u>
(2) Location: <u>1/4</u> , <u>1/4</u> , Sec. <u>1</u> , T. <u>1</u> R. <u>1</u>	<u>Blue clay</u>	<u>16</u>	<u>42</u>
<u>12</u> miles <u>E</u> of <u>Richton</u> (distance) (direction) (Nearest Town)	<u>Blue clay & small white sand streaks</u>	<u>63</u>	<u>105</u>
(3) Topography: <u>Hilly</u> (Hilly) (Flat) (Level)	<u>Blue shale</u>	<u>31</u>	<u>136</u>
(4) Purpose of Well: <u>Home</u> (Domestic Irrigation Municipal, Industrial, Other)	<u>Rock</u>	<u>2</u>	<u>138</u>
Information upon completion of well:			
(1) Diameter <u>2</u> inches.			
(2) Total Depth <u>200</u> feet.			
(3) Water Level <u>74</u> feet below top of ground.			
(4) Cased to <u>194'</u> , Size <u>2"</u>			
(5) Screen: Size <u>2"</u> , Length <u>6'</u>			
(6) Were any formations sealed against pollution? <u>no</u>			
If YES depth of formation _____			
Why _____			
Drillers Remarks: _____			

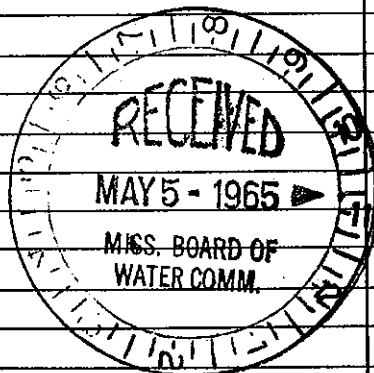

(Use Back Side)

Well No.

Mail this copy to Board of Water Commissioners 429 Miss. St. Jackson, Miss.