

A 32

(6)

10-64

WATER WELL DRILLERS LOG

Date: Oct, 1964, Driller: Peoples Drilling Co County: Greene
(Name)

(1) Owner of Land: <u>Miller Brewer</u> (Name)	Description & Color of Materials Sand, Clay, Red Clay, Shell, etc.	Thick- ness Feet	Depth Feet
<u>Richton</u> (Address)	<u>Yellow Sandy clay</u>	<u>25</u>	<u>25</u>
<u>10</u> (Address)	<u>Yellow Sand +</u>		
(2) Location: <u>1/4</u> , <u>1/4</u> , Sec. <u>10</u> T. <u>7</u> R. <u>1</u>	<u>Blue streak</u>	<u>27</u>	<u>52</u>
<u>10</u> miles <u>NE</u> of <u>Richton</u> (distance) (direction) (Nearest Town)	<u>Blue mud & sand</u>		
(3) Topography: <u>Hilly</u> (Hilly) (Flat) (Level)	<u>streak</u>	<u>11</u>	<u>63</u>
(4) Purpose of Well: <u>Home</u> (Domestic Irrigation Municipal, Industrial, Other)	<u>Gray sand</u>	<u>7</u>	<u>70</u>


Information upon completion of well:

- (1) Diameter 2 inches.
- (2) Total Depth 70 feet.
- (3) Water Level 52 feet below top of ground.
- (4) Cased to 64, Size 2"
- (5) Screen: Size 2", Length 6'
- (6) Were any formations sealed against pollution?
_____ yes, _____ no.

If YES depth of formation _____

Why _____

Drillers Remarks: _____

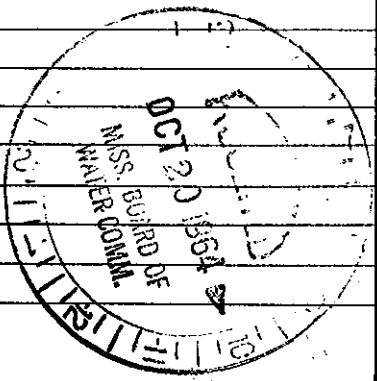

(Use Back Side)

Well No.