


GREENE MISSISSIPPI BOARD OF WATER COMMISSIONERS

A 36 (2)

3-66 WATER WELL DRILLERS LOG

Date: March, 1966, Driller Peoples Drilling Co County Greene
(Name)

(1) Owner of Land: <u>H V Stevenson</u>	Description & Color of Materials Sand, Clay, Red Clay, Shell, etc.	Thick- ness Feet	Depth Feet
<u>Rt 2</u> (Address)	<u>Yellow Sandy Clay</u>	<u>12</u>	<u>12</u>
<u>Richton, Miss</u> (Nearest Town)	<u>White Clay</u>	<u>9</u>	<u>21</u>
(2) Location: <u>2</u> Sec. <u>2</u> T <u>5</u> N R <u>8</u> E	<u>White clay & white</u>	<u>9</u>	<u>30</u>
<u>12</u> miles <u>NE</u> of <u>Richton</u>	<u>sand streaks</u>	<u>12</u>	<u>42</u>
(distance) (direction) (Nearest Town)	<u>Blue sandy clay</u>	<u>21</u>	<u>63</u>
(3) Topography: <u>Hilly</u>	<u>Brown clay & small</u>	<u>21</u>	<u>84</u>
(Hilly) (Flat) (Level)	<u>rock streaks</u>	<u>21</u>	<u>105</u>
(4) Purpose of Well: <u>Home</u>	<u>Green shale</u>	<u>32</u>	<u>137</u>
(Domestic Irrigation Municipal, Industrial, Other)	<u>Brown shale</u>	<u>10</u>	<u>147</u>
Information upon completion of well:	<u>Fine white sand</u>	<u>10</u>	<u>157</u>
(1) Diameter <u>2</u> inches.	<u>Green shale</u>	<u>42</u>	<u>199</u>
(2) Total Depth <u>321</u> feet.	<u>White sandy clay</u>	<u>42</u>	<u>241</u>
(3) Water Level <u>40</u> feet below top of ground.	<u>Green shale</u>	<u>74</u>	<u>315</u>
(4) Cased to <u>315'</u> , Size <u>2"</u>	<u>White sand (same</u>	<u>37</u>	<u>352</u>
(5) Screen: Size <u>2"</u> , Length <u>6'</u>	<u>yellow)</u>	<u>37</u>	<u>321</u>
(6) Were any formations sealed against pollution?			
_____ yes, _____ no.			
If YES depth of formation _____			
Why _____			
Drillers Remarks: _____			

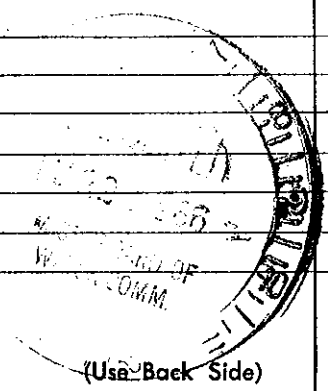

Well No.