

B3

10-64

WATER WELL DRILLERS LOG

Date: Oct, 1964, Driller: Peoples Drilling Co County Greene
 (Name)

(1) Owner of Land: <u>Willie Boyd</u> (Name)	Description & Color of Materials Sand, Clay, Red Clay, Shell, etc.	Thick- ness Feet	Depth Feet
<u>Richton</u> (Address)	<u>Yellow sandy clay</u>	<u>15</u>	<u>15</u>
(2) Location: <u>1/4, 1/4, Sec. 3 T5N7W</u>	<u>Yellow sand</u>	<u>19</u>	<u>31</u>
<u>17 miles NE</u> of <u>Richton</u> (distance) (direction) (Nearest Town)	<u>Yellow sand & clay</u>	<u>11</u>	<u>42</u>
(3) Topography: <u>Hilly</u> (Hilly) (Flat) (Level)	<u>struck</u>	<u>11</u>	<u>42</u>
(4) Purpose of Well: <u>Home</u> (Domestic Irrigation Municipal, Industrial, Other)	<u>Yellow sand</u>	<u>28</u>	<u>70</u>


Information upon completion of well:

- (1) Diameter 2 inches.
- (2) Total Depth 70 feet.
- (3) Water Level 53 feet below top of ground.
- (4) Cased to 44', Size 2"
- (5) Screen: Size 2", Length 6'
- (6) Were any formations sealed against pollution?
 yes, no.

If YES depth of formation _____

Why _____

Drillers Remarks: _____

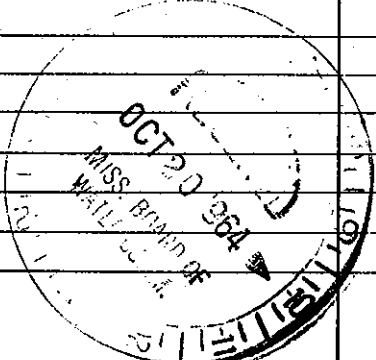

(Use Back Side)

Well No. _____