

Greene  
B 10  
3/14/78

MISSISSIPPI  
 BOARD OF WATER COMMISSIONERS  
 416 North State Street  
 Jackson, Mississippi 39201

WATER WELL DRILLERS LOG

March 14 1978 Porter Drilling & Log Greene  
 date well completed firm name county well located

LANDOWNER: Edgar Jones  
214 Richter, Miss

description of formations encountered	from	to
<u>clay</u>	<u>0</u>	<u>15</u>
<u>sand</u>	<u>15</u>	<u>63</u>
<u>clay</u>	<u>63</u>	<u>65</u>

(mailing address)

WELL LOCATION:  
 sec. 28 T 5 N R 7 E  
4 miles East of Landolt  
 (distance) (direction) (nearest town)

WELL PURPOSE: Home  
 (home, irrigation, municipal, industrial)

WELL COMPLETION DATA:  
 (1) diameter (inches) 2"  
 (2) total depth (feet) 60'  
 (3) static water level (feet) 36' below above top of ground.  
 (4) casing P.V.C. 55'  
 (material) (depth)  
2" If telescope see back.  
 (size)  
 (5) screen 5' 55'  
 (length) (depth to top)  
1 1/2" galv. S.S.  
 (size) (material)  
 (6) pump 1 10  
 (HP) (yield gpm)  
elec.  
 (type power)  
 (7) electric log no  
 (yes or no)  
 (organization running log)

(8) how well bottom plugged:  
1/4" back wash water

DRILLERS REMARKS:


**RECEIVED**

APR 1 1978



If well telescopes please sketch and show depths.

GROUND LEVEL

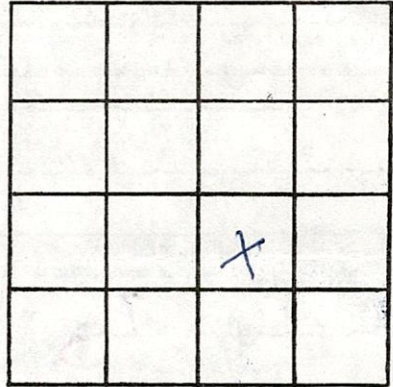

SECTION 28

Please indicate well location X.

ADDITIONAL INFORMATION

Multiple horizontal lines for recording additional information.

If more than one screen, show locations of each on sketch.