

FRANKLIN
 D3 D-1
 1-5-62

MISSISSIPPI BOARD OF WATER COMMISSIONERS

Done by John Aug 29-74

WATER WELL DRILLERS LOG **CODED**


Date: 1-5-1962, Driller: Layne-Central Co. County Greene

(Name)

(1) Owner of Land: State Line (Name)	Description & Color of Materials Sand, Clay, Red Clay, Shell, etc.	Thick- ness Feet	Dep Fee
State Line, Mississippi (Address)	clay	10	0-1'
(2) Location: 1/4, 1/4, Sec. 3 T5 R5	sand	17	37
_____ miles _____ of _____ (distance) (direction) (Nearest Town)	clay	35	72
(3) Topography: _____ (Hilly) (Flat) (Level)	sand	4	76
(4) Purpose of Well: Municipal (Domestic Irrigation Municipal, Industrial, Other)	clay & sand strks	34	110
Information upon completion of well:	sand & clay strks	28	138
(1) Diameter 8" inches.	gummy clay	49	187
(2) Total Depth 252' feet.	clay & sand strks	14	201
(3) Water Level 97' feet below top of ground.	coarse sand	58	259
(4) Cased to 205', Size 8"	gummy clay	18	277
(5) Screen: Size 6", Length 42'			
(6) Were any formations sealed against pollution? x yes, _____ no.			
If YES depth of formation 205'			
Why Required			
Drillers Remarks:			

CODED

gpm
100 + 7 lb pressure

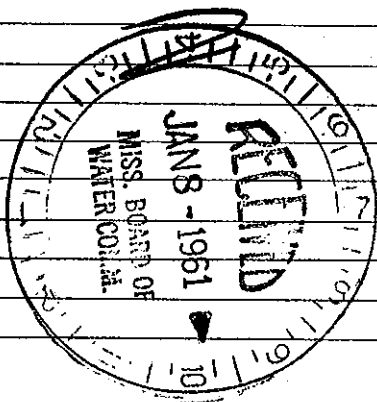

(Use Back Side)

Well No.

Mail this copy to Board of Water Commissioners 429 Miss. St. Jackson, Miss