

GREENE MISSISSIPPI BOARD OF WATER COMMISSIONERS

D 2
4-15-63

WATER WELL DRILLERS LOG

Date April 15, 1963, Driller Porter Drilling & Log County Green
(Name)

name

(1) Owner of Land: <u>Marvin Ware</u> (Name)	Description & Color of Materials Sand, Clay, Red Clay, Shell, etc.	Thick- ness Feet	Depth Feet
<u>Rt 2 State Line</u> (Address)	<u>red clay</u>	<u>15</u>	<u>15</u>
(2) Location: <u>SW 1/4, SE 1/4, Sec 32 T5R5</u>	<u>red sand</u>	<u>15</u>	<u>30</u>
<u>5</u> miles <u>south</u> of <u>State Line</u> (distance) (direction) (Nearest Town)	<u>red chaly</u>	<u>23</u>	<u>53</u>
(3) Topography: <u>Hilly</u> (Hilly) (Flat) (Level)	<u>blue chaly</u>	<u>9</u>	<u>62</u>
(4) Purpose of Well: <u>Domestic</u> (Domestic Irrigation Municipal, Industrial, Other)	<u>med coarse blue sand</u>	<u>3</u>	<u>65</u>
	<u>blue chaly</u>	<u>77</u>	<u>142</u>
	<u>fine sand</u>	<u>23</u>	<u>165</u>
	<u>fine sand & chaly</u>	<u>33</u>	<u>198</u>
	<u>med coarse clean sand</u>	<u>12</u>	<u>210</u>
	<u>stopped on chaly</u>		


Information upon completion of well:

- (1) Diameter 2" inches.
- (2) Total Depth 210' feet.
- (3) Water Level 87' feet below top of ground.
- (4) Cased to 201', Size 2"
- (5) Screen: Size 1/4", Length 9'
60 ga
- (6) Were any formations sealed against pollution?
yes, no.

If YES depth of formation _____

Why _____

Drillers Remarks: _____

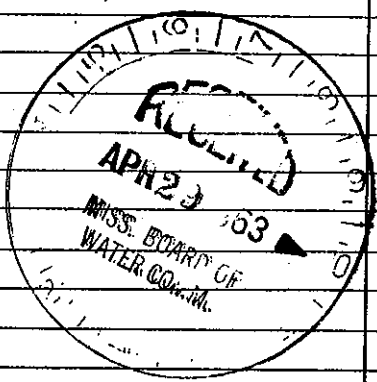

(Use Back Side)

Well No.

Mail this copy to Board of Water Commissioners 429 Miss. St. Jackson, Miss.