

MISSISSIPPI DEPARTMENT OF NATURAL RESOURCES

Bureau of Land and Water Resources

Southport Mall

P.O. Box 10631

Jackson, Mississippi 39209

WATER WELL DRILLERS LOG

Greene
D 2004
9-17-81

Sept 17 date well completed
W. Porter Drilling & Log firm name
Greene county well located

LANDOWNER: Paul Seabrook
State Line, Miss.
(mailing address)

WELL LOCATION:
sec. 7 T. 50^N R. 5 E S. 3
3 miles west State Line of (distance) (direction) (nearest town)

WELL PURPOSE: Home
(home, irrigation, municipal, industrial)

WELL COMPLETION DATA:
(1) diameter (inches) 2"
(2) total depth (feet) 220
(3) static water level (feet) 5' below top of ground.
(4) casing P.V.C. 215' (material) (depth)
2' (size) if telescope see back.
(5) screen 5' 215' (length) (depth to top)
2' below SS. (size) (material)
(6) pump 1 (HP) 8 (yield gpm)
elec. (type power)
(7) electric log no (yes or no)
(organization running log)
(8) how well bottom plugged
2 sand shark


description of formations encountered	from	to
Clay	0	15
sand	15	26
Clay	26	131
Clay & sand	131	160
Clay	160	195
very sand	195	220
stop on clay		

62' 1" P.V.C. drop pipe

DEPT. OF NATURAL RESOURCES
BUREAU OF LAND & WATER RESOURCES

SEP 18 1981

RECEIVED

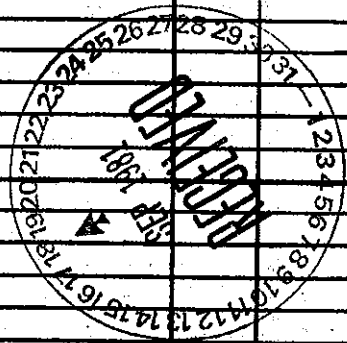

DRILLERS REMARKS: