

WATER COMMISSIONERS

GREENE

E 6
6764

⑥ WATER WELL DRILLERS LOG

Date: June, 1964, Driller: Peoples Drilling Co. County Greene
(Name)

(1) Owner of Land:	Description & Color of Materials Sand, Clay, Red Clay, Shell, etc.	Thick- ness Feet	Depth Feet
<u>Edgar Freeman</u> (Name) <u>Richston, Miss.</u> (Address)	0-42 Red & white clay		
(2) Location: <u>1/4</u> , <u>1/4</u> , Sec. <u>23</u> T. <u>18</u> R. <u>10</u> W.	42-87 white clay & sand		
<u>12</u> miles <u>E.S.E.</u> of <u>Richston</u> (distance) (direction) (Nearest Town)	87-200 white & grey clay		
(3) Topography: <u>Hilly</u> (Hilly) (Flat) (Level)	200-350 grey shale		
(4) Purpose of Well: <u>Domestic</u> (Domestic Irrigation Municipal, Industrial, Other)	350-400 grey shale & white sand		
	400-426 white sand		


Information upon completion of well:

- (1) Diameter 2" inches.
- (2) Total Depth 426' feet.
- (3) Water Level 100' feet below top of ground.
- (4) Cased to 420', Size 2".
- (5) Screen: Size 2", Length 6'.
- (6) Were any formations sealed against pollution?
yes, no.

If YES depth of formation _____

Why _____

Drillers Remarks: _____

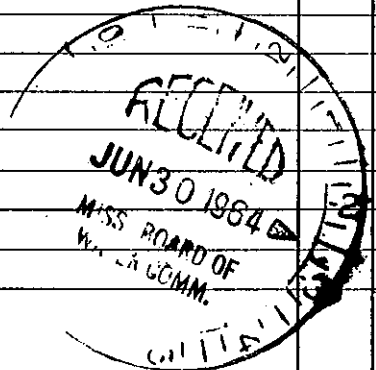

(Use Back Side)

Well No. _____

Mail this copy to Board of Water Commissioners 429 Miss. St. Jackson, Miss.