

GREENE MISSISSIPPI BOARD OF WATER COMMISSIONERS

E 7 ⑥
6-64

WATER WELL DRILLERS LOG

Date: June, 1964, Driller: Peoples Drilling Co. County Greene
(Name)

(1) Owner of Land:	Description & Color of Materials Sand, Clay, Red Clay, Shell, etc.	Thick- ness Feet	Depth Feet
<u>Alex. Walley</u> (Name) <u>Richston, Miss.</u> (Address)	<u>0-42 Red to white clay</u>		
	<u>42-126 Blue clay</u>		
(2) Location: <u>1/4</u> , <u>1/4</u> , Sec. <u>23</u> T. <u>4R</u> S. <u>2W</u>	<u>126-273 shale</u>		
<u>1.2</u> miles <u>E.S.E.</u> of <u>Richston</u> (distance) (direction) (Nearest Town)	<u>273-304 Grey shale & grey sand</u>		
(3) Topography: <u>Hilly</u> (Hilly) (Flat) (Level)	<u>304-390 Grey shale</u>		
(4) Purpose of Well: <u>Domestic</u> (Domestic Irrigation Municipal, Industrial, Other)	<u>390-432 Grey shale to white sand</u>		


Information upon completion of well:

- (1) Diameter 2 inches.
- (2) Total Depth 432 feet.
- (3) Water Level 85' feet below top of ground.
- (4) Cased to 432', Size 2"
- (5) Screen: Size 2", Length 6'
- (6) Were any formations sealed against pollution?
yes, no.

If YES depth of formation _____

Why _____

Drillers Remarks: _____

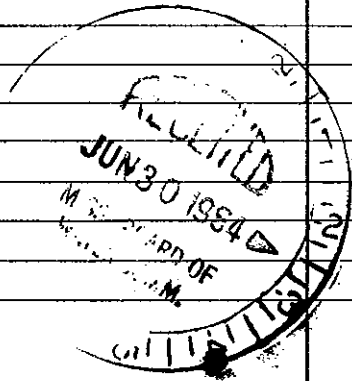

(Use Back Side)

Well No.

Mail this copy to Board of Water Commissioners 429 Miss. St. Jackson, Miss.