

GREENE MISSISSIPPI BOARD OF WATER COMMISSIONERS

E 8 ⑥
9-64

WATER WELL DRILLERS LOG

Date: Sept, 1964, Driller: Joseph D. Miller County Greene
(Name)

(1) Owner of Land:	Description & Color of Materials Sand, Clay, Red Clay, Shell, etc.	Thick- ness Feet	Depth Feet
(Name) <u>Rt 1 Rickman</u> (Address)	<u>White clay</u>	<u>12</u>	<u>12</u>
(2) Location: <u>1/4, 1/4, Sec. 16 T^{40N} R^{8W}</u>	<u>White sandy clay</u>	<u>41</u>	<u>53</u>
<u>1.0 miles SE</u> of <u>Rickman</u> (distance) (direction) (Nearest Town)	<u>Blue clay</u>	<u>20</u>	<u>73</u>
(3) Topography: <u>Hilly</u> (Hilly) (Flat) (Level)	<u>Blue sandy shale</u>	<u>21</u>	<u>94</u>
(4) Purpose of Well: <u>Home</u> (Domestic Irrigation Municipal, Industrial, Other)	<u>Blue sandy shale & sand shale</u>	<u>74</u>	<u>168</u>
	<u>Blue shale</u>	<u>115</u>	<u>283</u>
	<u>Sand & shale shale (white)</u>	<u>21</u>	<u>304</u>
	<u>white sand</u>	<u>28</u>	<u>332</u>


Information upon completion of well:

- (1) Diameter 2 inches.
- (2) Total Depth 332 feet.
- (3) Water Level 130 feet below top of ground.
- (4) Cased to 376', Size 2"
- (5) Screen: Size 2", Length 6'
- (6) Were any formations sealed against pollution?
yes, no.

If YES depth of formation _____

Why _____

Drillers Remarks: _____

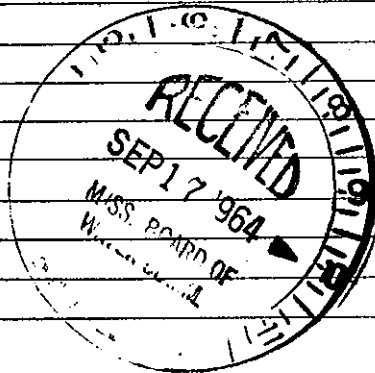

(Use Back Side)

Well No.

Mail this copy to Board of Water Commissioners 429 Miss. St. Jackson, Mis.