

Greene  
E-41  
9-3-80

MISSISSIPPI  
BOARD OF WATER COMMISSIONERS  
416 North State Street  
Jackson, Mississippi 39201

CODED

WATER WELL DRILLERS LOG

Griner Drilling Service, Inc

Greene

9-3-80 date well completed

firm name

county well located

LANDOWNER:  
Texas Crude  
700 Houston Natural  
Gas Bldg.  
1200 Travis St.  
Houston TX 77002

description of formations encountered	from	to
chalk	0	147
stratified	147	399
sand	399	462

WELL LOCATION: 2235' S + 900' W  
sec. 5 T 4 N R. 8 E of  
#1 well Sand Hill  
(distance) (direction) (nearest town)

WELL PURPOSE: oil field supply  
(home, irrigation, municipal, industrial)

- WELL COMPLETION DATA:
- (1) diameter (inches) 3"
  - (2) total depth (feet) 462'
  - (3) static water level (feet) 75' <sup>below</sup> above top of ground.
  - (4) casing Steel, 462'  
(material) (depth)  
3" if telescope see back.  
(size)
  - (5) screen 42', 420'  
(length) (depth to top)  
3" perforated  
(size) (material)
  - (6) pump 80  
(HP) (yield gpm)  
AC  
(type power)
  - (7) electric log (yes or no)
  - (organization running log)
  - (8) how well bottom plugged Orange  
peel

CODED

DEPT. OF NATURAL RESOURCES  
BUREAU OF LAND & WATER RESOURCES

SEP 29 1980


RECEIVED

DRILLERS REMARKS:



If well telescopes please sketch and show depths.

GROUND LEVEL

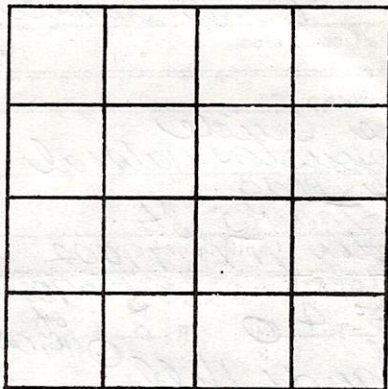

SECTION \_\_\_\_\_

Please indicate well location X.

ADDITIONAL INFORMATION

If more than one screen, show locations of each on sketch.