

State Well Report

Part 1 - Driller's Log

Mississippi Department of Environmental Quality
Office of Land and Water Resources
P.O. Box 10631
Jackson, MS 39289-0631
(601)961-5210
(601)354-6938 (fax)

County: Greene
Permit #:
Driller: Mike + Wade
Date drilling completed: 11-9-07

For Office Use Only:
Aquifer:
Well #: E-56
L. S. Elevation:
E-log #:

State Law requires that this report be prepared by the license holder responsible for the work and filed with the Department at the above address within 30 days of completion of drilling of the well or borehole.

Information on Well Owner (Landowner if borehole is not for a water well)
Owner Name: Diane Pope
Mailing Address: 1130 Pope Rd
Richton Ms 39426
City State Zip Code
Well or Borehole Location
Latitude: Longitude:
Method of Lat/Long (circle one): Conventional Survey, USGS quad, Hand-held GPS, Survey-grade GPS
1/4 1/4 Sec 14 Twn T4N Rng R8W
Distance 2 1/2 Miles Direction S of Nearest Town Sand Hill

Well / Borehole Data
Date drilling started: 11-8-07 Date drilling completed: 11-9-07 Hole depth: 335 Hole diameter: 4 1/2
Location of the source of any surface water used for drilling: NONE
Method of dosing and volume of Chlorine used in drilling and development:
Logs run (circle all applicable): No log run Electric Gamma Ray Density Sonic Neutron Other:
Name of organization running log(s):
Purpose of borehole (check one): Water Well [checked] Geotechnical/Geological Investigation Ground Source Heat Pump
Seismic Survey Other (describe) test hole
If drilling is not related to water well construction, skip the remainder of this block

Purpose of Well (check one): Home Industrial Public Supply Irrigation Fish Culture Other: Farm
If a flowing well, method of flow regulation: Valve Other (describe)
Static Water Level: feet above or below (circle one) land surface Date measured:
Method of Measurement (circle one) steel tape electric tape air line other:
Well depth: Well grouted to a depth of feet Type of grout (circle one): Neat Cement Bentonite Mix
Casing length: feet Casing diameter: inches Type of casing:
Screen length: feet Screen diameter: inches Type of screen:
Screen slot size: inches Setting depth: From feet to feet
Type of completion (circle all applicable): Gravel packed Underreamed Telescoped Open hole Natural Development
Other (describe):
Top of lap pipe or reduction in casing: feet. If telescoped or more than one screen, describe on next page


Form: OLWR-SWR-1A

Plugged and Abandoned

RECEIVED
DEC 12 2007
BY: OLWR

The sketch below only required for water wells

If well telescopes, show depths on sketch.

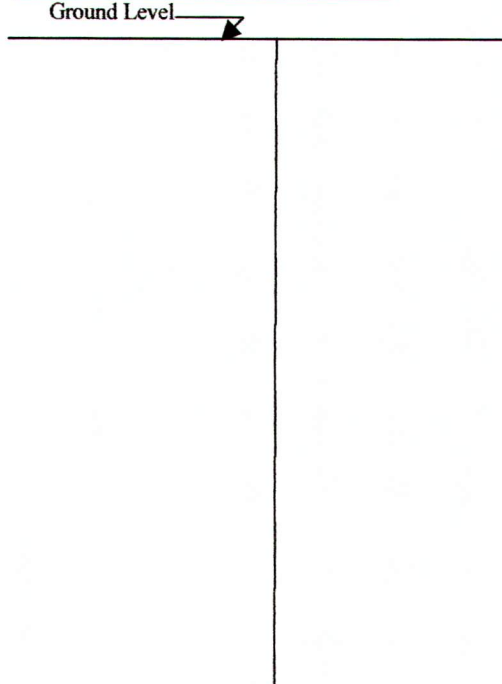

Description of formations encountered must be provided for all wells and boreholes, unless specifically exempted by regulations

Description of Formations Encountered	From (depth) To (depth)	
	Ground Level	
Clay	0	8
Sand	8	15
Clay	15	16
sand	16	40
Clay	40	75
fine sand silt	75	85
Blue Clay	85	130
fine sand	130	134
Clay	134	254
sand	254	258
Clay	258	270
silt	270	290
rock	290	292
silt	292	315
Clay	315	335

If more than one screen, show location of each on sketch

Sketch the property layout and include the following: 1) the well location; 2) any permanent structures on the property that may aid in locating the well; 3) any roads, power lines, or other items that may aid in locating the property and the well; 4) a north arrow.

Landowner Name: Diane Pope

Form: OLWR-SWR-1A

I certify that the well/borehole was drilled, constructed, and completed in accordance with all applicable requirements of the Mississippi Department of Environmental Quality and the Mississippi Department of Health regulations, if applicable, and state laws.

Michael R Fry 0408 11-9-07
 Print Name of Responsible Licensee and License No. Date

Michael R Fry
 Signature of Licensee

RECEIVED
 DEC 12 2007
 BY: OLWR