	State Well Report	
County: Greene	Part 1 – Driller's Log	For Office Use Only:
	Mississippi Department of Environmental Quality	Aquifer:
Permit #:	Office of Land and Water Resources	Well #: E59
Driller: Michael S. Harard	P.O. Box 10631	weil #
	Jackson, MS 39289-0631	L. S. Elevation:
Date drilling completed: 8-20-09	(601)961-5210	
	(601)354-6938 (fax)	E-log #:

з

State Law requires that this report be prepared by the license holder responsible for the work and filed with the Department at the above address within 30 days of completion of drilling of the well or borehole.

(Landowner if borehole is not for a water well) Owner Name_Cleves_Browcr Mailing Address: Mailing Address: P.O. Box 56 7 USGS quad. Lackeville Mailing Address: P.O. Box 56 7 USGS quad. Lackeville Mailing Address: P.O. Box 56 7 USGS quad. USGS quad. Lackeville Mailing Address: P.O. Box 56 7 USGS quad. USGS quad. Lackeville Mailing Address: P.O. Box 56 7 USGS quad. USGS quad. Lackeville Mailing Address: Part of randowners State Zip Code Well / Borehole Data Date drilling and development: Logs run (circle all applicable): Date or organization running log(s): Purpose of borehole (check one): Water Well X Geotechnical/Geological Investigation	Information on Well Owner	Well or Borehole Location
Owner Name_Cletus_Brr.Str 0.2 Mailing Address: P.O. Box 56 7 Mailing Address: Mailes Mailing Address: P.O. Box 56 7 Mailing Address: Mailes Mailes Mailes Maile drilling is and related for Mailes	(Landowner if borehole is not for a water well)	
Mailing Address: P.O. Box 56? Lickville Mailing Address: Lickville Mailing Construction Mailing Address: Mailing Address: Lickville Mailing Address: Lickville Mailing Address: Lickville Mailing Address: Mailing Address: Mailing Address: Lickville Mailing Address: Mailing Address: Mailing Address: Mailing Statte Statte Color Mailing Statte Statte Color Mailing Statte Mailing Construction Mailing Statte Mail Geological Investigation Statte of Cele color Mail Geological Invest	Owner Name Clicks Brower	$\Delta 1$ $\partial 2$
USGS quad, Encled GPS Survey-grade GPS Lickbrille MS State Zip Code Telephone No. (Lot.) 314-5085 Well / Borchole Data Date drilling started: §-20-09 Mathe do dosing and volume of Chlorine used in drilling: Method of dosing and volume of Chlorine used in drilling: Method of organization running log(s): Purpose of borehole (check one): Water Well X Geotechnical/Geological Investigation Grund Source Heat Pump		Method of Lat/Long (circle one): Conventional Survey,
Lukwille MS 39451 City State Zip Code Telephone No. (Loc) 344-5085 Distance Well / Borehole Data Date drilling started: \$20-09 Date drilling completed: \$20-69 Hole depth: 38' Hole diameter: 4.5'' Location of the source of any surface water used for drilling: Method of dosing and volume of Chlorine used in drilling and development:	Mailing Address: Y.O, Sox 367	USGS guad Hand-beld GPS Survey-grade GPS
Lickwill Name State Zip Code Distance Direction Nearest Town Telephone No. (Lot) 314-5085		
H Miles Mil	1 Vill my sailer	NZ 1/4 NW/4 Sec_ 2 OF wn_ 1974 Rng K8W
H Miles Mil	City State Zin Code	Distance Direction Nearest Town
Well / Borehole Data Date drilling completed: \$-20-69 Hole depth: 38' Hole diameter: 4.5'' Location of the source of any surface water used for drilling:	•	<u>4</u> Miles <u>W</u> of <u>SandHill</u>
Date drilling started: \$.20.69 Hole depth: 38' Hole diameter: 4.5'' Location of the source of any surface water used for drilling:	Telephone No. (601) 314 - 5085	
Date drilling started: \$.20.69 Hole depth: 38' Hole diameter: 4.5'' Location of the source of any surface water used for drilling:	Well / Bor	abola Data
Location of the source of any surface water used for drilling:		
Location of the source of any surface water used for drilling:	Date drilling started: 8-20-09 Date drilling completed: 8-20-	69 Hole depth: Hole diameter:
Method of dosing and volume of Chlorine used in drilling and development: Logs run (circle all applicable) Electric Gamma Ray Density Sonic Neutron Other: Name of organization running log(s): Electric Gamma Ray Density Sonic Neutron Other: Purpose of borehole (check one): Water Well X Geotechnical/Geological Investigation Ground Source Heat Pump_ Seismic SurveyOther (describe)		
Logs run (circle all applicable) Electric Gamma Ray Density Sonic Neutron Other: Name of organization running log(s): Purpose of borehole (check one): Water Well X Geotechnical/Geological Investigation Ground Source Heat Pump	Method of dosing and volume of Chlorine used in drilling and deve	lopment:
Name of organization running log(s): Purpose of borehole (check one): Water Well X Geotechnical/Geological Investigation Ground Source Heat Pump	•	
Seismic SurveyOther (describe)		Density Sonic Neutron Other:
Seismic SurveyOther (describe)		
If drilling is not related to water well construction, skip the remainder of this block Purpose of Well (check one): Home X Industrial Public Supply Irrigation Fish Culture Other:	Purpose of borehole (check one): Water Well A Geotechnical/Geo	logical Investigation Ground Source Heat Pump
Purpose of Well (check one): Home X Industrial Public Supply Irrigation Fish Culture Other:	Seismic Survey Other (<i>describe</i>	e)
If a flowing well, method of flow regulation: ValveOther (describe)	If drilling is not related to water well construction	on, skip the remainder of this block
If a flowing well, method of flow regulation: ValveOther (describe)	Purpose of Well (check one): Home 👗 Industrial Public Suppl	y Irrigation Fish Culture Other:
Static Water Level: 21 feet above or below (circle one) land surface Date measured: § - 20 - 09 Method of Measurement (circle one) steel tape electric tape air line other: Well depth: 38 Well grouted to a depth offeet Type of grout (circle one): Neat Cement Bentonite Mix Casing length: 33 feet Casing diameter: 2 inches Type of casing: PVC S40 SE Screen length: 5 feet Screen diameter: 2 inches Type of screen: PVC WO Screen slot size: Setting depth: From 33 feet to 38 feet Type of completion (circle all applicable): Gravel packed Underreamed Telescoped Open hole Natural Development Other (describe):		
Method of Measurement (circle one) steel tape electric tape air line other:		
Well depth: 38 Well grouted to a depth offeet Type of grout (circle one): Neat Cement Bentonite Mix Casing length: 33 feet Casing diameter: 2 inches Type of casing: PVC 540 8E Screen length: 5 feet Screen diameter: 2 inches Type of screen: PVC WOP Screen slot size: 08 inches Setting depth: From 33 feet to 38 feet Type of completion (circle all applicable): Grave nacked Underreamed Telescoped Open hole Natural Development Other (describe):	Static Water Level:feet above or below (circle one)	land surface Date measured: 3.20-01
Casing length: 33 feet Casing diameter: 2 inches Type of casing: PVC S40 SE Screen length: 5 feet Screen diameter: 2 inches Type of screen: PVC WOP Screen slot size: . . . Setting depth: From 33 feet to . . Type of completion (circle all applicable): . <td< th=""><th>Method of Measurement (circle one) steel tape</th><th>air line other:</th></td<>	Method of Measurement (circle one) steel tape	air line other:
Screen length:	Well depth: 38 Well grouted to a depth offeet Typ	e of grout (circle one): Neat Cement Bentonite Mix
Screen length:	Casing length: <u>33</u> feet Casing diameter: <u>2</u>	inches Type of casing: PVC 540 BE
Screen slot size: . 008 inches Setting depth: From		
Type of completion (circle all applicable): Inderreamed Telescoped Open hole Natural Development Other (describe):		
Other (describe):		
Top of lap pipe or reduction in casing:feet. If telescoped or more than one screen, describe on next page		
	Other (describe):	
	Top of lap pipe or reduction in casing: feet. If the	elescoped or more than one screen, describe on next page
		Form: OLWR-SWR-1A

RECEIVED OCT 2 3 2009 BY: OLWR


The sketch below only required for water wells

If well telescopes, show depths on sketch. Ground Level.

Description of formations encountered must be provided for all wells and boreholes, unless specifically exempted by regulations E59

Description of Formations Encountered	From (depth) 7 Ground Level	5
Class	5	12
Sind	12	38
· · · · · · · · · · · · · · · · · · ·		
· · ·		
1 10		

If more than one screen, show location of each on sketch

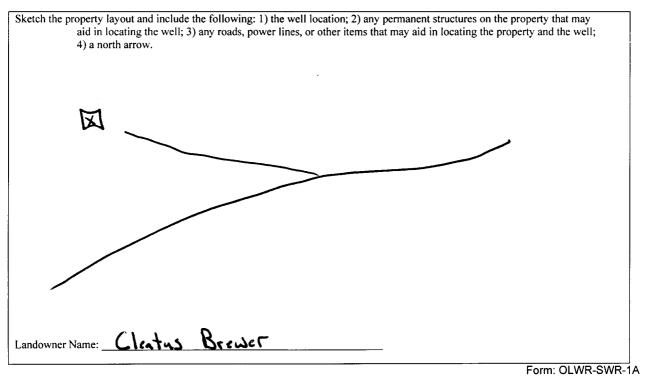

I certify that the well/borehole was drilled, constructed, and completed in accordance with all applicable requirements of the Mississippi Department of Environmental Quality and the Mississippi Department of Health regulations, if applicable, and state

laws. Havard 0-673 10-16-09 ٢. MA Date

1.10

Print Name of Responsible Licensee and License No.

Signature of Licensee

RECEIVED OCT 2 3 2009 BY: OLMA

		STATE W	ELL REPORT		
County: Green	<u>د</u>		Part 2	For Office Use Only:	
Permit #:		Pump Installer's Completion Report Mississippi Department of Environmental Quality		Aquifer:	
Driller: Michae		Office of Land	Office of Land and Water Resources P.O. Box 10631 Jackson, MS 39289-0631		
Date completed:	•	Jackson,			
Copy information fro		· · · ·	1)961-5210 354-6938 (fax)	Elevation:	
] pted hv a licensed water wel	l contractor or a licensed numn i	installer. A copy of Part 1 of the	
report must be atta	iched and both part	s filed with the Department	at the above address within 30 a	lays of well completion.	
	Well Owner Infor			Il Location	
Owner Name:	.lctus Ur	<i>cwcr</i>	Latitude: N 31° 20.682	_Longitude: ??* \7,03	
Mailing Address:	r.o. Box	567	Method of Lat/Long (check o	ne): Conventional Survey,	
			USGS quad, Hand-held	GPS★, Survey-grade GPS	
Leakesville MS 39451 City State Zip Code		1/4 1/4 Sec_ 3			
			Distance Direction		
Felephone No. (60	1) 394 - 509	35	$ \underline{\mathbf{H}}_{\text{Miles}} \underline{\mathbf{L}}_{\text{o}} $	of SandHill	
Pump Type Circle one		Power Type Circle one			
Air Lift	(let)	Submersible	Diesel Engine Gasoli	ne Engine Natural Gas	
				5	
Bucket	Piston	Turbine	Electric Motor Hand		
Centrifugal	Rotary	Flowing Well	Windmill Other	(specify):	
Other (specify):			Horse Power Rating of Motor		
Date Pump Installed	d: <u>8-20-</u>	09	Setting Depth: 32	feet	
		Gallons Per Minute	Number of Stages:		
	ny. <u>10</u>	Ganons i er lynnute		· · · · · · · · · · · · · · · · · · ·	
XF +	Pump Test D	ata		easuring Water Level	
Date Well Tested:				Circle one	
Static Water Level		Feet Below Land Surface	Air Line Electric Mea	asuring Dne Steel Tape	
			Other (specify):		
Pumping Water Lev		Feet Below Land Surface			
Drouvdown [(B) - (A)]: 	Feet Below Land Surface		hut in head:feet	
	10	Gallons Per Minute	Well yielded	GPM with a drawdown of	
Test Pumping Rate:			q feet after	4 hours of pumping	
Test Pumping Rate	Fest (minimum 4 ho	urs): H hours	Teet after	nours or pumping	

Υ , • Υ , · · ·

OCT 2 3 2009

BY: OLWR