

State Well Report

Part 1 - Driller's Log

Mississippi Department of Environmental Quality
Office of Land and Water Resources
P.O. Box 2307
Jackson, MS 39225
(601)961- 5210
(601)961- 5228 (fax)

County: Greene
Permit #: _____
Driller: Mike & Wade
Date drilling completed: 1-21-11

For Office Use Only:
Aquifer: 6 24
Well #: _____
L. S. Elevation: _____
E-log #: _____

State Law requires that this report be prepared by the license holder responsible for the work and filed with the Department at the above address within 30 days of completion of drilling of the well or borehole.

Information on Well Owner (Landowner if borehole is not for a water well)	Well or Borehole Location
Owner Name: <u>Hayton Clark</u>	Latitude: <u>31° 20' 01"</u> Longitude: <u>88° 34' 01"</u>
Mailing Address: <u>14530 Old Avey Rd</u>	Method of Lat/Long (circle one): Conventional Survey, USGS quad, Hand-held GPS, Survey-grade GPS
<u>Stalder</u> <u>39362</u>	<u>4W</u> 1/4 <u>SW</u> 1/4 Sec <u>2</u> Twn <u>T4N</u> Rng <u>R6W</u>
City State Zip Code	Distance Direction Nearest Town
Telephone No. ()	<u>6</u> Miles <u>SW</u> of <u>Stalder</u>

Well / Borehole Data

Date drilling started: 1-21-11 Date drilling completed: 1-21-11 Hole depth: 240 Hole diameter: 4 1/2

Location of the source of any surface water used for drilling: NONE
Method of dosing and volume of Chlorine used in drilling and development: _____

Logs run (circle all applicable): No log run Electric Gamma Ray Density Sonic Neutron Other: _____
Name of organization running log(s): _____

Purpose of borehole (check one): Water Well Geotechnical/Geological Investigation _____ Ground Source Heat Pump _____
Seismic Survey _____ Other (describe) _____
If drilling is not related to water well construction, skip the remainder of this block

Purpose of Well (check one): Home Industrial _____ Public Supply _____ Irrigation _____ Fish Culture _____ Other: _____

If a flowing well, method of flow regulation: Valve _____ Other (describe) _____

Static Water Level: 4 feet above or below (circle one) land surface Date measured: _____

Method of Measurement (circle one) steel tape electric tape air line other: _____

Well depth: 240 Well grouted to a depth of 10 feet Type of grout (circle one): Neat Cement Bentonite Mix

Casing length: 220 feet Casing diameter: 2 inches Type of casing: PVC 40

Screen length: 20 feet Screen diameter: 2 inches Type of screen: PVC wrapped

Screen slot size: 8 inches Setting depth: From 020 feet to 24 feet

Type of completion (circle all applicable): Gravel packed Underreamed Telescoped Open hole Natural Development
Other (describe): _____

Top of lap pipe or reduction in casing: _____ feet. *If telescoped or more than one screen, describe on next page*


Form: OLWR-SWR-1A (04/08)

RECEIVED
FEB 16 2011
BY: OLWR

The sketch below only required for water wells

If well telescopes, show depths on sketch.

Ground Level →

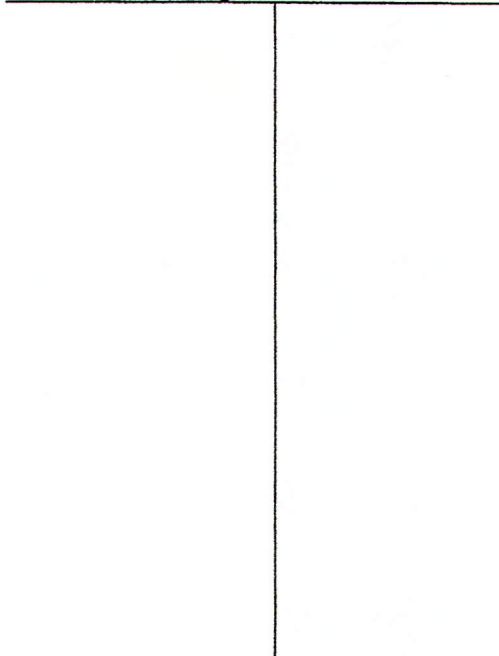


If more than one screen, show location of each on sketch

Description of formations encountered must be provided for all wells and boreholes, unless specifically exempted by regulations

626

Description of Formations Encountered	From (depth)	To (depth)
	Ground Level	
Clay	0	2
sand	2	4
Clay	4	28
sand	28	38
Clay	38	39
sand	39	65
soft Clay silt	65	140
sand	140	190
Clay	190	220
fine silty sand	220	225
sand	225	240

Sketch the property layout and include the following: 1) the well location; 2) any permanent structures on the property that may aid in locating the well; 3) any roads, power lines, or other items that may aid in locating the property and the well; 4) a north arrow.

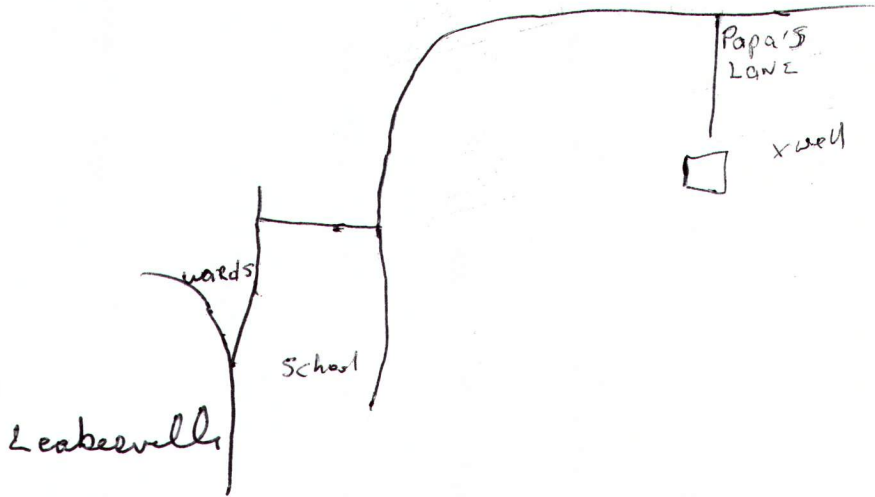

Landowner Name: Dayton Clark

Form: OLWR-SWR-1A (04/08)

I certify that the well/borehole was drilled, constructed, and completed in accordance with all applicable requirements of the Mississippi Department of Environmental Quality and the Mississippi Department of Health regulations, if applicable, and state laws.

Michael R Fry / 0408 / 1-21-11

Print Name of Responsible Licensee and License No.

Date

Michael R Fry

Signature of Licensee

RECEIVED

FEB 16 2011

BY: OLWR

STATE WELL REPORT

Part 2

Pump Installer's Completion Report
 Mississippi Department of Environmental Quality
 Office of Land and Water Resources
 P.O. Box 2309
 Jackson, MS 39225
 (601)961-5210
 (601)961-5228 (fax)

County: Greene
 Permit #: _____
 Driller: Mike I Wade
 Date completed: 1-25-11
Copy information from block on Part 1

For Office Use Only:

Aquifer: _____
 Well #: _____
 Elevation: _____

This part of the report must be completed by a licensed water well contractor or a licensed pump installer. A copy of Part 1 of the report must be attached and both parts filed with the Department at the above address within 30 days of well completion.

Well Owner Information	Well Location
Owner Name: <u>Dayton Clark</u>	Latitude: _____ Longitude: _____
Mailing Address: <u>94530 Oldway Rd</u>	Method of Lat/Long (check one): Conventional Survey _____
<u>Slato Len</u> 39362	USGS quad _____, Hand-held GPS _____, Survey-grade GPS _____
City State Zip Code	_____ 1/4 _____ 1/4 Sec <u>2</u> <u>T4N R6W</u>
Telephone No. () _____	Distance Direction Nearest Town
	<u>6</u> Miles <u>SW</u> of <u>Slato Len</u>

Pump Type Circle one	Power Type Circle one
Air Lift <input type="radio"/> Jet <input checked="" type="radio"/> Submersible	Diesel Engine Gasoline Engine Natural Gas
Bucket <input type="radio"/> Piston <input type="radio"/> Turbine	<input checked="" type="radio"/> Electric Motor <input type="radio"/> Hand <input type="radio"/> Tractor PTO
Centrifugal <input type="radio"/> Rotary <input type="radio"/> Flowing Well	Windmill Other (specify): _____
Other (specify): _____	Horse Power Rating of Motor: <u>1/2</u>
Date Pump Installed: <u>1-25-11</u>	Setting Depth: <u>20</u> feet
Rated Pump Capacity: <u>6-10</u> Gallons Per Minute	Number of Stages: <u>1</u>

Pump Test Data	Method of Measuring Water Level Circle one
Date Well Tested: _____	Air Line Electric Measuring Line Steel Tape
Static Water Level (A): <u>4' above</u> Feet Below Land Surface	Other (specify): _____
Pumping Water Level (B): <u>2' above</u> Feet Below Land Surface	For flowing well, measured shut in head: _____ feet
Drawdown [(B) - (A)]: <u>2</u> Feet Below Land Surface	Well yielded <u>6</u> GPM with a drawdown of
Test Pumping Rate: <u>6</u> Gallons Per Minute	<u>2</u> feet after <u>1 1/2</u> hours of pumping
Duration of Pump Test (minimum 4 hours): <u>4</u> hours	

I HEREBY CERTIFY that the above statements are true to the best of my knowledge.

Michael R Fryfogel 0408 Michael R Fryfogel
 Print Name of Pump Installer and License No. (if applicable) Signature of Pump Installer

Form: OLWR-SWR-1B (04/08)

RECEIVED
 FEB 16 2011
 BY: OLWR