

MISSISSIPPI DEPARTMENT OF ENVIRONMENTAL QUALITY

Office of Land and Water Resources

P. O. Box 10631
Jackson, MS 39289-0631
WATER WELL DRILLERS LOG

COUNTY WELL LOCATED <i>Green</i>	
WELL NUMBER <i>G 2014</i>	CODED
DATE WELL COMPLETED <i>10-1-77</i>	

0408

PERMIT NUMBER <i>English Well Ser.</i>
NAME OF DRILLING FIRM <i>194 Depot Rd</i>
<i>Guadalupe MS 39452</i>

NAME & MAILING ADDRESS OF LANDOWNER <i>Van Elmore</i>	
<i>Rt 2</i>	
<i>Beckerhill MS 39451</i>	
WELL LOCATION <i>State Line Rd</i>	SEC <i>23</i> TWP <i>T4</i> RANGE <i>S R 6 E</i>
DISTANCE <i>10</i> Miles	DIRECTION <i>N</i> of <i>Beckerhill</i>
OTHER LANDMARK <i>Above Lake Luther</i>	
WELL PURPOSE <i>Home Irrigation, Municipal, Industrial, Fish Pond, etc.</i>	

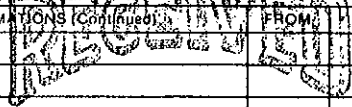
PUMP DATA		
PUMP TYPE (Circle One): <input checked="" type="radio"/> Submersible <input type="radio"/> Turbine <input type="radio"/> Jet <input type="radio"/> Flowing Well, Other (Describe) _____		
POWER TYPE (Circle One): <input checked="" type="radio"/> Electric <input type="radio"/> Tractor <input type="radio"/> Diesel <input type="radio"/> Gasoline <input type="radio"/> Butane, Other (Describe) _____ H/P <i>1</i>		
Pump Capacity (GPM) <i>10</i>	No. of Stages <i>14</i>	Setting Depth <i>110'</i> FT.
PUMP TEST		
Well yielded <i>20</i> GPM with a drawdown of <i>0</i> ft. after <i>24</i> hours of pumping		

WELL DATA		
Well Depth <i>120'</i>	Casing Diameter (In.) <i>4"</i>	Casing Length (Ft.) <i>110'</i>
Type of Casing <i>PVC</i>	Hole Depth <i>120'</i>	Depth to Static Water Level <i>75'</i>
TYPE OF COMPLETION: (Circle One or More): <input checked="" type="radio"/> Gravel Packed <input type="radio"/> Underreamed <input type="radio"/> Telescoped, <input checked="" type="radio"/> Natural Development <input type="radio"/> Open Hole <input type="radio"/> Other (Describe) <i>air lift</i>		
WELL GROUTED TO A DEPTH OF <i>20'</i> FEET Type Grout (circle one): <input checked="" type="radio"/> Cement <input type="radio"/> Bentonite <input type="radio"/> or Mix		

LOG DATA	
TYPE OF LOG RUN (Circle One): <input type="radio"/> No Log Run, <input type="radio"/> Electric, <input type="radio"/> Gamma Ray, <input type="radio"/> Density, <input type="radio"/> Sonic, <input type="radio"/> Neutron, Other (Describe) _____	
Name of Organization Running Log	

GEOLOGIC DATA (Office Use Only)			
Surface Elev.	Geologic Unit	Unit Thickness	Depth to Top
Subs. SWL	Date	Analysis	Aquifer Test
Driller's Remarks			
Top of Lap Pipe or Reduction in Casing			
FEET IF TELESCOPED OR MORE THAN ONE SCREEN: USE BACK PAGE			

SCREEN DATA		
Diameter - Inches <i>4"</i>	Length - Feet <i>10'</i>	Slot Size - Inches <i>#8</i>
Screen Type <i>Wrapped</i>	Depth to Bottom - Feet <i>120'</i>	

DESCRIPTION OF FORMATIONS ENCOUNTERED	FROM	TO	FORMATIONS (Continued)	FROM	TO
<i>Top S</i>	<i>0</i>	<i>5</i>	 JAN 21 1993 Dept. of Environmental Quality Office of Land & Water Resources		
<i>Clay</i>	<i>5</i>	<i>20</i>			
<i>Sand</i>	<i>20</i>	<i>33</i>			
<i>Clay</i>	<i>33</i>	<i>41</i>			
<i>Clay</i>	<i>41</i>	<i>60</i>			
<i>Clay</i>	<i>60</i>	<i>100</i>			
<i>Wash Sand</i>	<i>100</i>	<i>110</i>			
<i>Coarse Sand</i>	<i>110</i>	<i>120</i>			

IF MORE SPACE IS NEEDED, USE BACK