

3

Greene
HI
12-67

MISSISSIPPI
BOARD OF WATER COMMISSIONERS
416 North State Street
Jackson, Mississippi 39201

WATER WELL DRILLERS LOG

FEB 1967 PEEPLES DRILLING Co GREENE
date well completed firm name county well located

LANDOWNER: MRS. MARIE LEWIS	description of formations encountered	from	to
VINEGAR BEND	YELLOW SANDY CLAY	0	18
ALA. (mailing address)	WHITE SANDY CLAY	18	60
WELL LOCATION: sec. 10 T. 4 N. R. 5 E. S. 6 W. (W) of FRUITDALE ALA. (nearest town)	FINE WHITE SAND	60	100
(distance) (direction)	YELLOW SANDY CLAY	100	189
WELL PURPOSE: CHICKEN FARM (home, irrigation, municipal, industrial)	WHITE SAND & CLAY STREAKS	189	210
	WHITE SAND	210	245

WELL COMPLETION DATA:

(1) diameter (inches) 2

(2) total depth (feet) 245

(3) static water level (feet) 102 below top of ground.

(4) casing GALV (material) 239 (depth)
2 (size) if telescope see back.

(5) screen 6' (length) 239 (depth to top)
2 (size) BRASS (material)


(6) pump 3/4 (HP) 3 (yield gpm)

ELECT (type power)

(7) electric log NO (yes or no)

(organization running log)

(8) how well bottom plugged BACK WASH VALVE

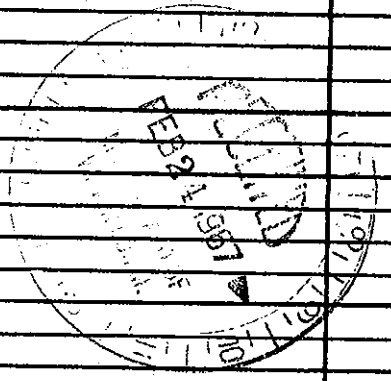

DRILLERS REMARKS: