

GREENE

MISSISSIPPI BOARD OF WATER COMMISSIONERS

N K3

USGS File

WATER WELL DRILLERS LOG

K-300

10-2-60

Date: Oct 28, 1960, Driller: Robertson County, Greene

(Name)

(1) Owner of Land:	Description & Color of Materials Sand, Clay, Red Clay, Shell, etc.	Thick- ness Feet	Depth Feet
(Name) <u>Stanley E. Smith</u> (Address) <u>Merby Star Rt.</u>	<u>0-82 Clay</u> <u>82-90 Sand & gravel</u>		
(2) Location: <u>NW 1/4, NW 1/4, Sec. 8 T3 R7</u> <u>6 miles South</u> of <u>Merby</u> (distance) (direction) (Nearest Town)			
(3) Topography: <u>Hilly</u> (Hilly) (Flat) (Level)			
(4) Purpose of Well: <u>Home</u> (Domestic Irrigation Municipal, Industrial, Other)			


Information upon completion of well:

- (1) Diameter 2ⁱⁿ inches.
- (2) Total Depth 90 feet.
- (3) Water Level 58 feet below top of ground.
- (4) Cased to 36 ft, Size 2"
- (5) Screen: Size 2", Length 5 ft
- (6) Were any formations sealed against pollution?
 yes, no.

If YES depth of formation _____

Why _____

Drillers Remarks: _____

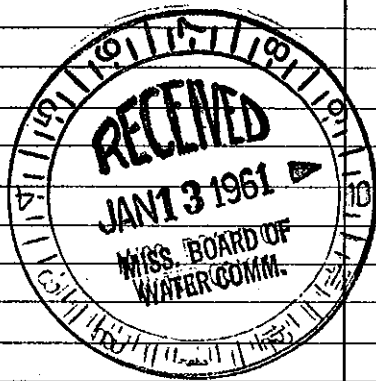

Well No. 500

(Use Back Side)

Mail this copy to Board of Water Commissioners 429 Miss. St. Jackson, Miss.