

GREENE

K10

8-16-66

MISSISSIPPI BOARD OF WATER COMMISSIONERS

CODED

WATER WELL DRILLERS LOG

Date: 8-16, 1966, Driller: Tim MCR County Green
(When well drilled) (Name) (Where well is located)

(1) Owner of Land: <u>A.R. Smith</u> (Name)	Description & Color of Materials Sand, Clay, Red Clay, Shell, etc.	Thick- ness Feet	Depth Feet
<u>STAR RT Neely</u> (Address)	<u>CLAY</u>	<u>0</u>	<u>18</u>
(2) Location: <u>1/4, 1/4, Sec. 6 T3R7W</u>	<u>SAND</u>	<u>18</u>	<u>50</u>
<u>3</u> miles <u>S-W</u> of <u>Acero</u> (distance) (direction) (Nearest town)			
(3) Topography: <u>X</u> (Hilly) (Flat) (Level)			
(4) Purpose of Well: <u>Domestic</u> (Domestic Irrigation Municipal, Industrial, Other)			

CODED

Information upon completion of well:

- (1) Diameter 2 inches.
- (2) Total Depth 50 feet.
- (3) Water Level 30 feet below top of ground.
- (4) Cased to 50, Size 2
- (5) Screen: Size 2, Length 5
- (6) Were any formations sealed against pollution?
_____ yes, no.

If YES depth of formation _____


Why _____

Drillers Remarks: _____

Yield in gpm: 6

Size pump: 3/4

Type power: jet

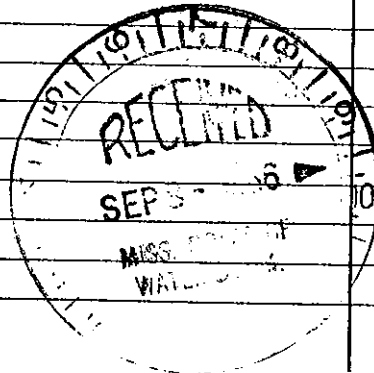

Mail this copy to Board of Water Commissioners 429 Miss. St. Jackson, Miss.