

GREENE

L5 ③

10-13-60

MISSISSIPPI BOARD OF WATER COMMISSIONERS

WATER WELL DRILLERS LOG

L 300

Date: Oct. 13, 1960, Driller: Hattiesburg Butane Co. County Green

(Name)

(1) Owner of Land: Mr. & Mrs S.E. Dickson (Name)	Description & Color of Materials Sand, Clay, Red Clay, Shell, etc.	Thick- ness Feet	Depth Feet
Leaksville, Miss. (Address)	Yellow Clay		0-15
(2) Location: NW 1/4, SE 1/4, Sec. 35 T3 R-W	Yellow Sand		15-40
2 1/2 miles North of Leaksville (distance) (direction) (Nearest Town)	Blue Clay		40-90
(3) Topography: Hilly (Hilly) (Flat) (Level)	Blue Sand		90-100
(4) Purpose of Well: Domestic (Domestic Irrigation Municipal, Industrial, Other)	Blue Clay		100-150
	Blue Sand		150-170
	Blue Clay		173-190
	Blue Sand		190-240


Information upon completion of well:

- (1) Diameter 2 inches.
- (2) Total Depth 240 feet.
- (3) Water level 44' feet below top of ground.
- (4) Cased to _____, Size _____
- (5) Screen: Size 2 Inch, Length 5'
- (6) Were any formations sealed against pollution?
_____ yes, no.

If YES depth of formation _____

Why _____

Drillers Remarks: _____

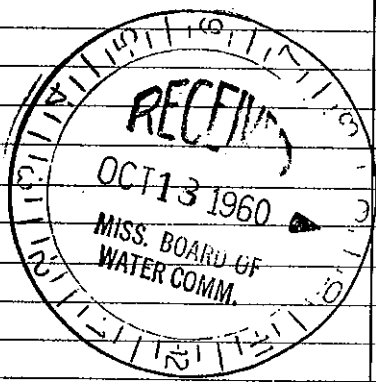

Well No.

(Use Back Side)

Mail this copy to Board of Water Commissioners 429 Miss. St. Jackson, Miss.